IREDELL COUNTY HEALTH DEPARTMENT

STATESVILLE 704-878-5305 MOORESVILLE 704-664-5281

IMPROVEMENT PERMIT / AUTHORIZATION TO CONSTRUCT / OPERATION PERMIT / EXISTING SYSTEM INSPECTION

PERMIT# 093320 PIN# 4659 44 1869 DATE 11/27/00

OWNER OR CONTRACTOR Dave Hill PHONE: Business 660-0900 Home

ADDRESS 151 Freeze Crossing Dr.

LOCATION 115-21N TR Freeze Rd to 7th lot on (L)

SUBDIVISION Freeze Crossing BLOCK / SECTION LOT 7 LOT AREA .69AC SITE CLASS. DESIGN FLOW 360 L.T.A.R. 2.35

Septic Tank: EXISTING Gallons; STB Date

Pump Tank: Gallons; PT Date

Pump Make: Model Serial No.

Nitrification Field: No Fields EXISTING Square Feet Linear Feet 345

No Lines 3 Trench Width 3' Max Trench Bottom Depth Gravel Depth

☐ New System ☐ Repair System Type: I (II) III, IV, V, VI

System Description: EXISTING SYSTEM

Repair System Description:

Maintenance Agreement Required: ☐ Yes ☒ No

☒ House/Mod. Home No. Bedrooms 3

☐ Mobile Home No. Bathrooms 3

☐ Business No. Employees

☐ Other

☐ Slab ☒ Crawl Space ☐ Basement w/plumbing ☐ Basement wo/plumbing


Water Supply: ☒ Individual ☐ Public ☐ Community

Comments:/Conditions:

Comments:/Conditions: 11/27/00 No signs of malfunction on this unit.

INITIAL SITE SKETCH

AS BUILT SKETCH

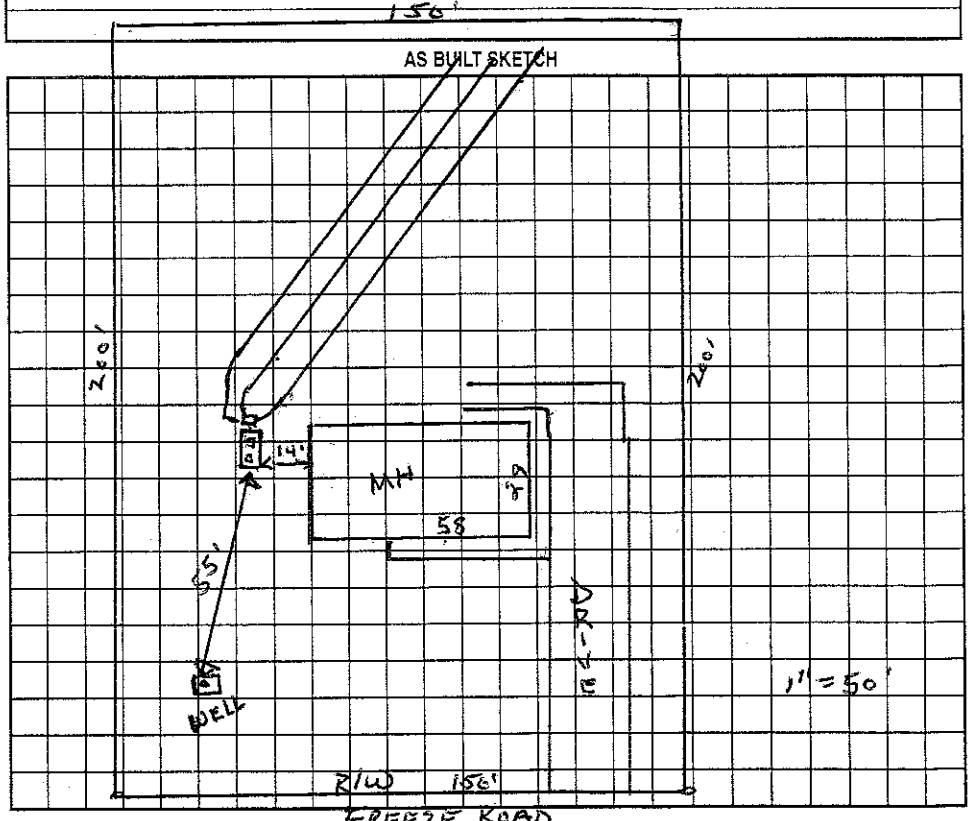

Permit can be suspended or revoked if any false information is supplied toward securing the permit/any unauthorized changes are made to the site/any unauthorized changes are made in the installation of the system. Improvement Permit with plat valid without expiration. Improvement Permit with site plan valid for sixty months. Authorization to Construct is valid for a period equal to that of Improvement Permit – not to exceed sixty months.

Signed: date

Improvement Permit by: date

Authorization to Construct by: date

Installed by:

Operation Permit by: date

Existing System Inspection by: Wesley Sparks R.S. date 11/27/00

HEALTH DEPT. COPY: WHITE OWNER COPY (FINAL): YELLOW OWNER COPY (INITIAL): PINK