IREDELL COUNTY HEALTH DEPARTMENT

STATESVILLE 704-878-5305 MOORESVILLE 704-664-5281

IMPROVEMENT PERMIT / AUTHORIZATION TO CONSTRUCT / OPERATION PERMIT / EXISTING SYSTEM INSPECTION

PERMIT# 074336 PIN# 4659 44 2687 DATE 7/30/98

OWNER OR CONTRACTOR MICHAEL RAUCH PHONE: Business Home 660-5554

ADDRESS 152 FREEZE CROSSING

LOCATION 21N- TR FREEZE CROSSING 6th ON RT

SUBDIVISION FREEZE CROSSING BLOCK / SECTION LOT 27 LOT AREA .81 AC SITE CLASS. BS DESIGN FLOW 360+ 50GAL T.A.R. .3

Septic Tank: 900 + 1000 Gallons; STB 1100 Date 9/30/98
Pump Tank: Gallons; PT Date
Pump Make: Model Serial No.
Nitrification Field: No Fields 1 Square Feet 1500 Linear Feet 500
No Lines 4+1@100' Trench Width 36" Max Trench Bottom Depth 36" Gravel Depth 12"

☑ New System ☐ Repair System Type: I (II) III, IV, V, VI
System Description: GRAVITY CONVENTIONAL
Repair System Description: SAME
Maintenance Agreement Required: ☐ Yes ☑ No

☐ House/Mod. Home No. Bedrooms 5
☑ Mobile Home No. Bathrooms 2
☑ Business No. Employees
☐ Other DOG GROOMING - 10 GAL PER DOG

☐ Slab ☐ Crawl Space ☐ Basement w/plumbing ☐ Basement wo/plumbing


Water Supply: ☑ Individual ☐ Public ☐ Community

Comments/Conditions: NEW TANK IS TO HAVE ~~RISER~~ HAIR FILTER IN PLACE OF SANITARY TEE AND RISER FOR PUMP ACCESS. - IF OLD DIST BOX ~~HAS~~ 5 OUTLETS - NO DROP BOX IS REQUIRED.

Comments/Conditions: 5 DOGS

Installed as shown.

INITIAL SITE SKETCH

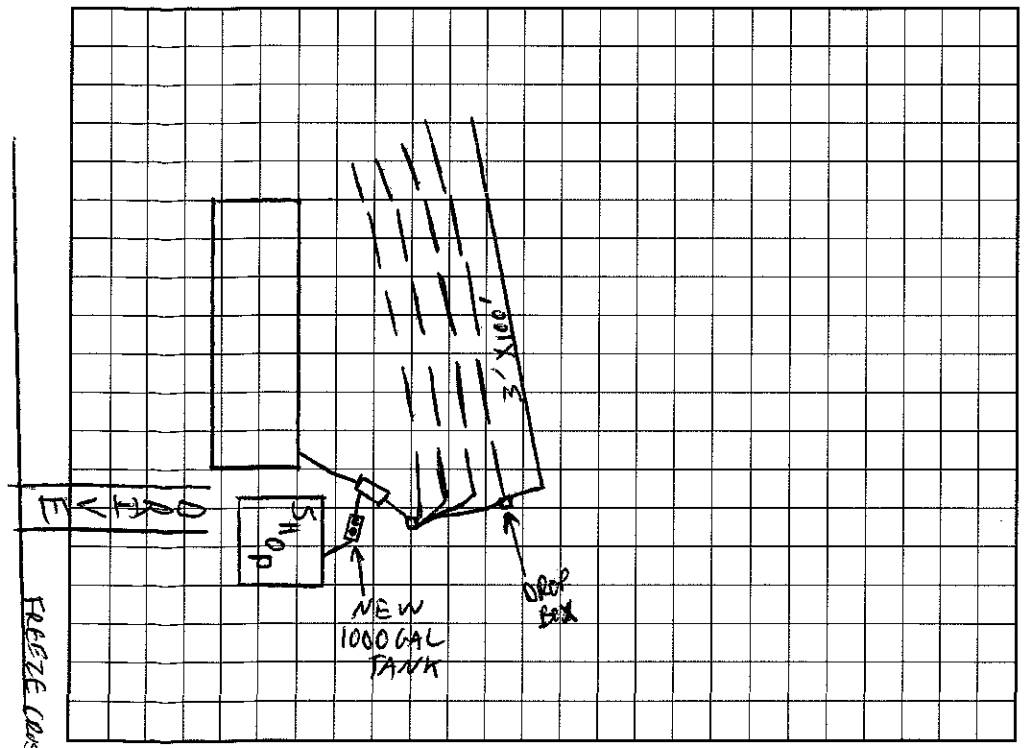

AS BUILT SKETCH

I understand that this permit can be suspended or revoked if any false information is supplied toward securing the permit/any unauthorized changes are made to the site/any unauthorized changes are made in the installation of the system. Improvement Permit with plat valid without expiration. Improvement Permit with site plan valid for sixty months. Authorization to Construct is valid for a period equal to that of Improvement Permit – not to exceed sixty months.

Signed: Jill Karpik-Rauch date 8/5/98
Improvement Permit by: C. Lynn Toms RS date 7/30/98
Authorization to Construct by: C. Lynn Toms RS date 7/30/98

Installed by: Seymour Septic Tank
Operation Permit by: Wesley Sparks 125 date 11/10/98
Existing System Inspection by: date

HEALTH DEPT. COPY: WHITE INSPECTION COPY (FINAL): GREEN OWNER COPY (FINAL): YELLOW INSPECTION COPY (INITIAL): PINK OWNER COPY (INITIAL): GOLD