IREDELL COUNTY HEALTH DEPARTMENT

STATESVILLE 704-878-5305 MOORESVILLE 704-664-5281

IMPROVEMENT PERMIT / CERTIFICATE OF COMPLETION / OPERATION PERMIT / EXISTING SYSTEM INSPECTION

AUTHORIZATION TO CONSTRUCT (11:00)

PROPERTY DESCRIPTION NO. 26377 DATE 4/4/97 TAX MAP NO. 4659 44 8448 Watershed: ☐ Yes ☒ No

OWNER OR CONTRACTOR NELSON OSBORNE PHONE: Business Home 857-4117

ADDRESS 180 GULLEDGE ST. CHINA GROVE NC 28023

LOCATION 21/115 N TR FREEZE CROSSING ON RT NEAR END

SUBDIVISION FREEZE CROSSING BLOCK / SECTION LOT 22 LOT AREA 4.477AC SITE CLASS. RS DESIGN FLOW 430GPD L.T.A.R. 3600 FT²

Septic Tank: 1000 Gallons; STB 825 Date 5/21/97

Pump Tank: Gallons; PT Date

Pump Make: Model Serial No.

Nitrification Field: No Fields 1 Square Feet 1605 Linear Feet 535

No Lines 10 Trench Width 36" Max Trench Bottom Depth 30" Gravel Depth 12"

☒ New System ☐ Repair System Type: I (II) III, IV, V, VI

System Description: GRAVITY CONVENTIONAL

Repair System Description: SAME

Maintenance Agreement Required: ☐ Yes ☒ No

☐ House/Mod. Home ☒ Mobile Home ☐ Business ☐ Other

No. Bedrooms 4 No. Bathrooms 3 No. Employees


☐ Slab ☒ Crawl Space ☐ Basement w/plumbing ☐ Basement wo/plumbing

Water Supply: ☒ Individual ☐ Community ☐ Public


Comments: SET FLOW DIVIDER WITH TWO DISTRIBUTION BOXES. KEEP WELL AT LEAST 40' OFF OF ANY PROPERTY LINE

Comments:

INITIAL SITE SKETCH 1"=100'

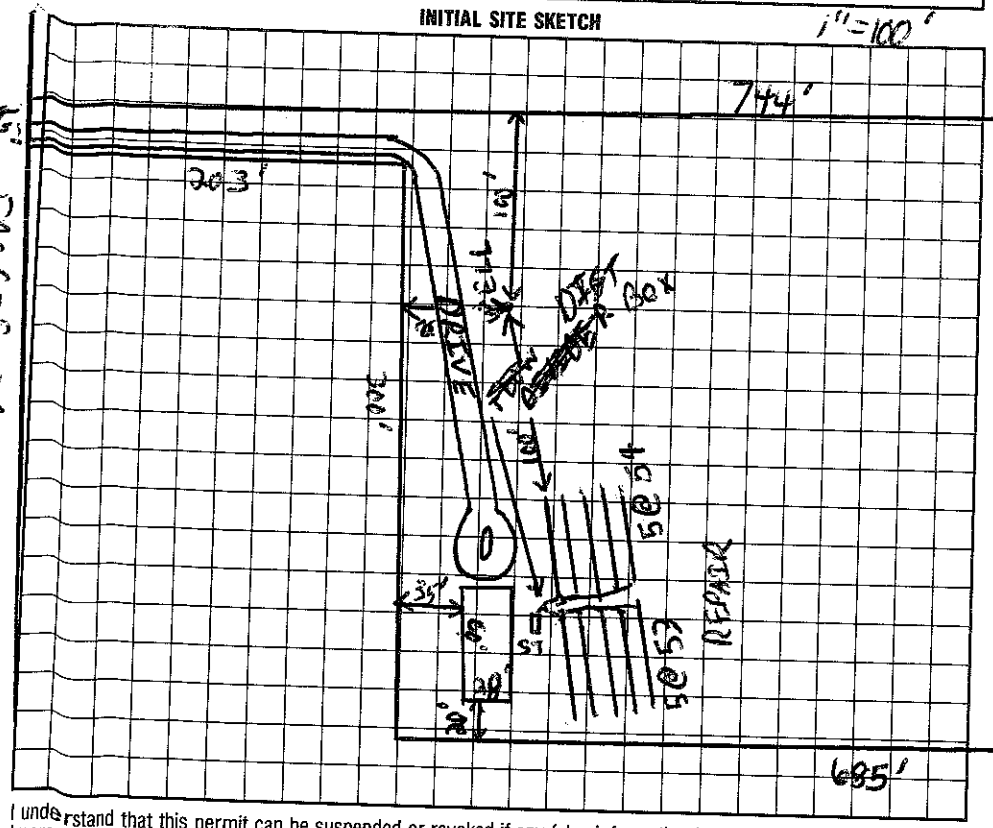

AS BUILT SKETCH

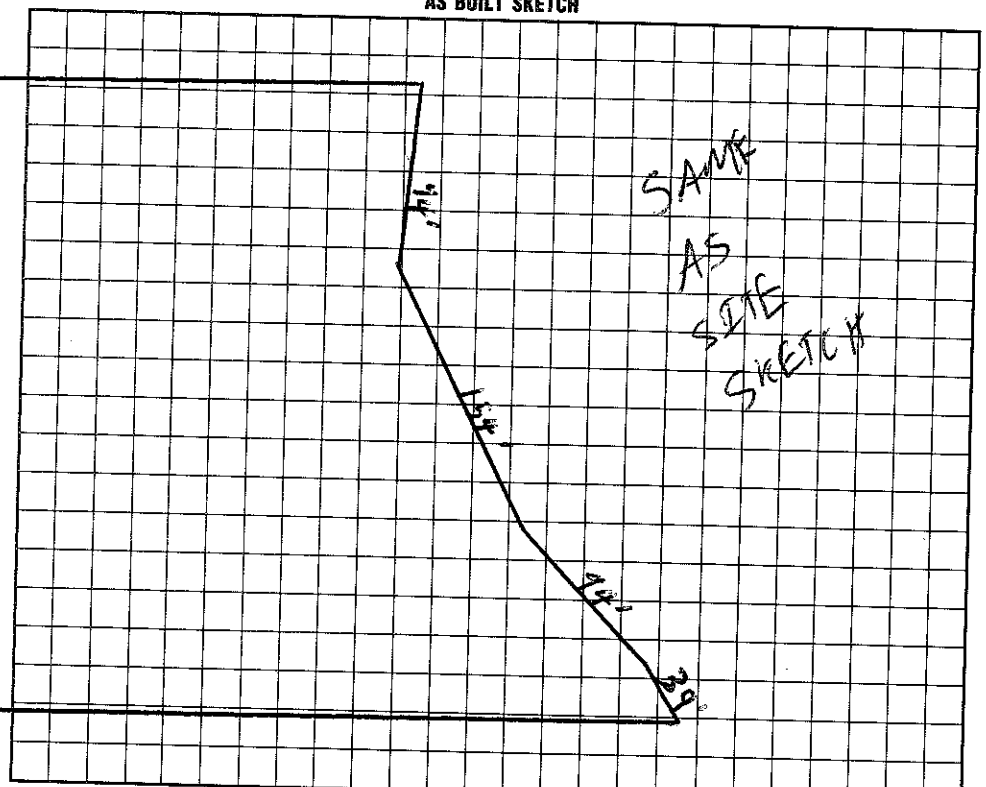

I understand that this permit can be suspended or revoked if any false information is supplied toward securing the permit/any unauthorized changes are made to the site/any unauthorized changes are made in the installation of the system. Improvement Permit is valid for 60 months from date of issuance.

Signed: Nelson Osborne

Improvement Permit by: date 4/4/97

AUTHORIZATION TO CONSTRUCT

Existing System Inspection by: date 4/4/97

Installed by: FOSTER POOL & CONSTRUCTION

Certificate of Completion by: date

Operation Permit by: date 8/13/97

HEALTH DEPT. COPY: WHITE INSPECTION COPY (FINAL): GREEN OWNER COPY (FINAL): YELLOW INSPECTION COPY (INITIAL): PINK OWNER COPY (INITIAL): GOLD