IREDELL COUNTY HEALTH DEPARTMENT

STATESVILLE 704-878-5305 MOORESVILLE 704-664-5281

IMPROVEMENT PERMIT / AUTHORIZATION TO CONSTRUCT / OPERATION PERMIT / EXISTING SYSTEM INSPECTION

PERMIT# 080408 PIN# 4659552609 4659-45-9479 DATE 5/6/99

OWNER OR CONTRACTOR John Wiles PHONE: Business 704-663-7346 Home

ADDRESS 120 Orange Ln, Mooresville NC 28115

LOCATION 21N, TR Freeze Crossing, Th Cedar Crest, on Rt

SUBDIVISION ——— BLOCK / SECTION — LOT — LOT AREA 5.00 AC SITE CLASS. PS DESIGN FLOW 360 L.T.A.R. .3

Septic Tank: 1000 Gallons; STB 160 Date 6/11/99
Pump Tank: ——— Gallons; PT ——— Date ———
Pump Make: ——— Model ——— Serial No. ———
Nitrification Field: No Fields 1 Square Feet 1200 Linear Feet 400
No Lines 4 @ 100 Trench Width 36" Max Trench Bottom Depth 36" Gravel Depth 12"

☒ New System ☐ Repair System Type: I, (II) III, IV, V, VI
System Description: Gravel/Conv.
Repair System Description: Same
Maintenance Agreement Required: ☐ Yes ☐ No


☒ House/Mod. Home No. Bedrooms 3
☐ Mobile Home No. Bathrooms 2
☐ Business No. Employees ___
☐ Other ———
☐ Slab ☒ Crawl Space ☐ Basement w/plumbing ☐ Basement wo/plumbing

Water Supply: ☒ Individual ☐ Public ☐ Community

Comments:/Conditions:

Comments:/Conditions:
Installer is using Drop Boxes & tank location has changed.

INITIAL SITE SKETCH Not to Scale

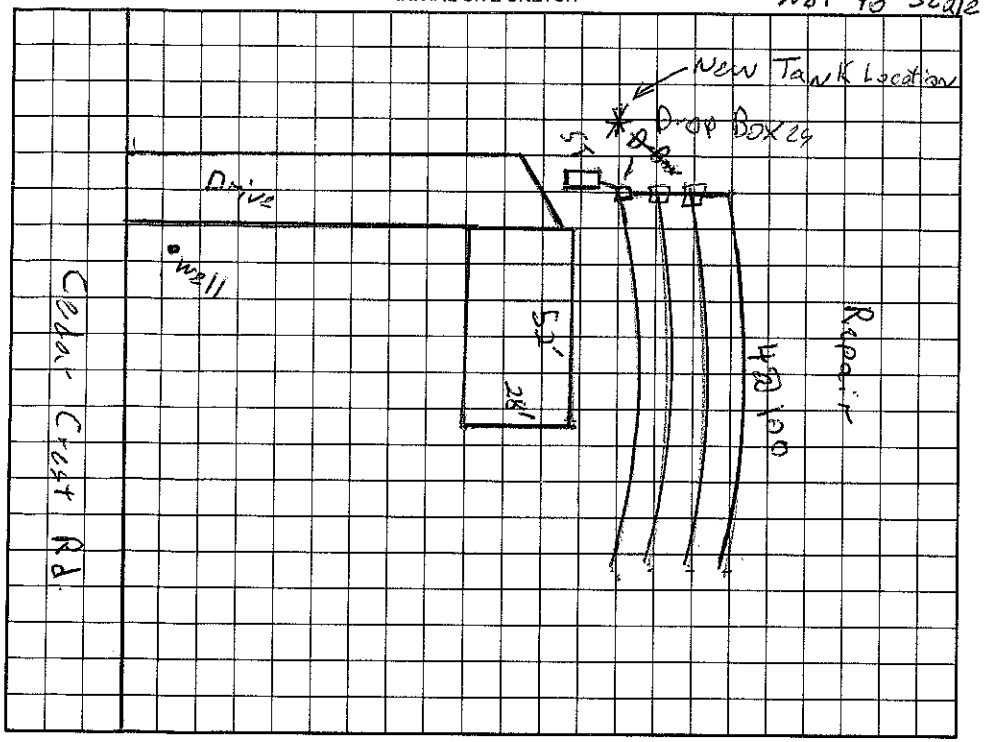

AS BUILT SKETCH

Permit can be suspended or revoked if any false information is supplied toward securing the permit/any unauthorized changes are made to the site/any unauthorized changes are made in the installation of the system. Improvement Permit with plat valid without expiration. Improvement Permit with site plan valid for sixty months. Authorization to Construct is valid for a period equal to that of Improvement Permit – not to exceed sixty months.

Signed: John R Wiles date 5.7.99 Installed by: Billy Eckards

Improvement Permit by: Jeff Morgan date 5/6/99 Operation Permit by: Jeff Morgan date 8/2/99

Authorization to Construct by: Jeff Morgan date 5/6/99 Existing System Inspection by: ——— date ———

HEALTH DEPT. COPY: WHITE OWNER COPY (FINAL): YELLOW OWNER COPY (INITIAL): PINK