IREDELL COUNTY HEALTH DEPARTMENT

STATESVILLE 704-878-5305 MOORESVILLE 704-664-5281

IMPROVEMENT PERMIT / CERTIFICATE OF COMPLETION / OPERATION PERMIT / EXISTING SYSTEM INSPECTION

PROPERTY DESCRIPTION NO. 17257 DATE 10/26/93 TAX MAP NO. 4E44 Watershed: ☑ Yes ☐ No

OWNER OR CONTRACTOR KITH CARROLL CUSTOM HOMES PHONE: Business 664-1155 ~~Home~~ 459-46-0789

ADDRESS PO BOX 431 MT MOURNE, NC. 28123

LOCATION WEST MORELAND RD TR TO 5TH LUTON ©

SUBDIVISION LAUREL WOOD BLOCK / SECTION ____ LOT 5 LOT AREA 20,048 SITE CLASS. P DESIGN FLOW 360 L.T.A.R. .25

Septic Tank: 1000 Gallons; STB 794 Date 1/14/94

Pump Tank: ____ Gallons; PT ____ Date ____

Pump Make: ____ Model ____ Serial No. ____

Nitrification Field: No Fields 1 Square Feet 1260 Linear Feet 240

No Lines X5 Trench Width 2' Max Trench Bottom Depth 30" Gravel Depth 6"

☑ New System ☐ Repair System Type: I, II, IV, V, VI

System Description: ~~CRAW~~ PPBS 16"

Repair System Description: PPBS 16"

Maintenance Agreement Required: ☐ Yes ☑ No

☑ House/Mod. Home No. Bedrooms 3

☐ Mobile Home No. Bathrooms 2

☐ Business No. Employees ____

☐ Other ____

☐ Slab ☑ Crawl Space ☐ Basement w/plumbing ☐ Basement wo/plumbing

Water Supply: ☑ Individual ☑ Community ☐ Public


Comments:

112'

TRENCH BOTTOM 30" MAX


.5 REDUCTION FOR PANEL BLOCKS

INITIAL SITE SKETCH

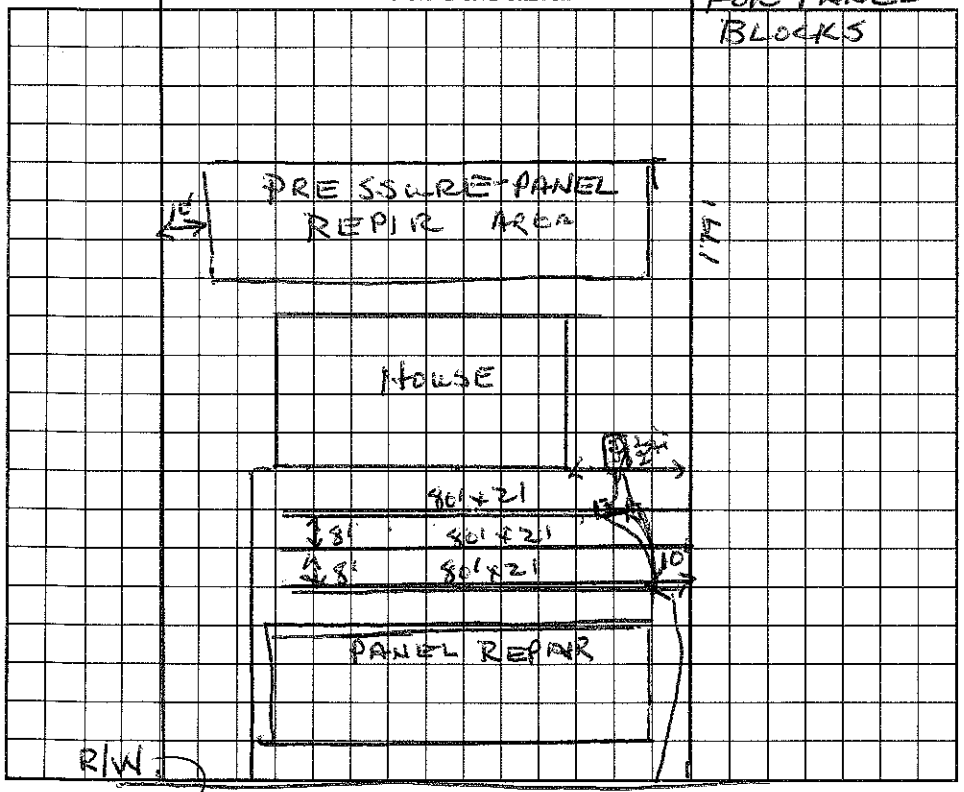

Comments:

AS BUILT SKETCH

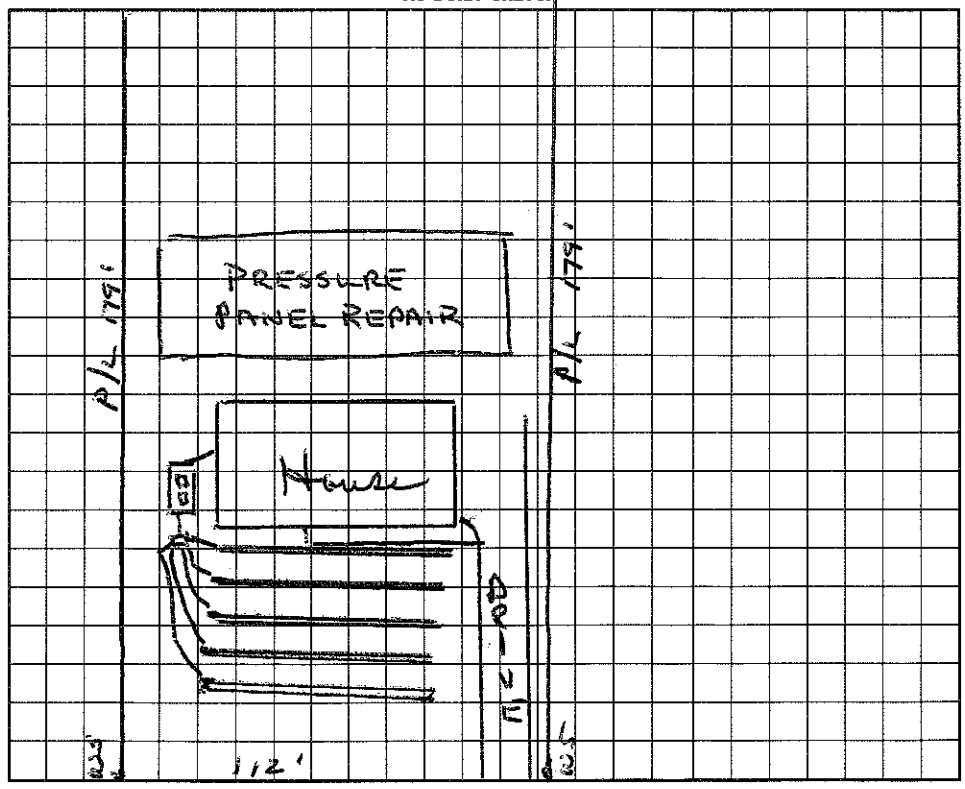

I understand that this permit can be suspended or revoked if any false information is supplied toward securing the permit/any unauthorized changes are made to the site/any unauthorized changes are made in the installation of the system. Improvement Permit is valid for 60 months from date of issuance.

Signed: EQUESTRIAN DR. EQUESTRIAN DR.

Improvement Permit by: Wesley Sparks R.S. date 10/26/93

Existing System Inspection by: ____ date ____

Installed by: F J Ervin

Certificate of Completion by: Wesley Sparks R.S. date 4/12/94

Operation Permit by: ____ date ____

HEALTH DEPT. COPY: WHITE INSPECTION COPY (FINAL): GREEN OWNER COPY (FINAL): YELLOW INSPECTION COPY (INITIAL): PINK OWNER COPY (INITIAL): GOLD