IREDELL COUNTY HEALTH DEPARTMENT

STATESVILLE 704-878-5305 MOORESVILLE 704-664-5281

IMPROVEMENT PERMIT / CERTIFICATE OF COMPLETION / OPERATION PERMIT / EXISTING SYSTEM INSPECTION

PROPERTY DESCRIPTION NO. 17256 DATE 10/26/93 TAX MAP NO. 4E A4 Watershed: ☐ Yes ☐ No

OWNER OR CONTRACTOR KEITH CARROLL CUSTOM HOMES PHONE: Business 664-1155 ~~Home~~ 465-46-0950

ADDRESS PO Box 431 Mt. Mourne, NC.

LOCATION WESTMORELAND RD, TR INTO LAURELWOOD TO 4th LOT ON (L)

SUBDIVISION LAURELWOOD BLOCK / SECTION 1 LOT 4 LOT AREA ~20,160 SITE CLASS. P DESIGN FLOW 360 L.T.A.R. .25-.3

Septic Tank: 1000 Gallons; STB 358 Date 3/3/94
Pump Tank: ____ Gallons; PT ____ Date ____
Pump Make: ____ Model ____ Serial No. ____
Nitrification Field: No Fields 1 Square Feet 1200 Linear Feet 240
No Lines 4 Trench Width 36" Max Trench Bottom Depth 30" ~~Gravel~~ SAND Depth 12"

☐ New System ☐ Repair System Type: I, II, III, IV, V, VI
System Description: PP PBS 16"
Repair System Description: PP BPS 16"
Maintenance Agreement Required: ☐ Yes ☑ No


☑ House/Mod. Home No. Bedrooms 3
☐ Mobile Home No. Bathrooms 2
☐ Business No. Employees ____
☐ Other ____
☐ Slab ☑ Crawl Space ☐ Basement w/plumbing ☐ Basement wo/plumbing

Water Supply:
☐ Individual
☑ Community
☐ Public


Comments: TRENCHES SHALLOW - NO DEEPER THAN 30" TO TRENCH BOTTOM
* .5 REDUCTION FOR PANEL BLOCK

Comments:

INITIAL SITE SKETCH

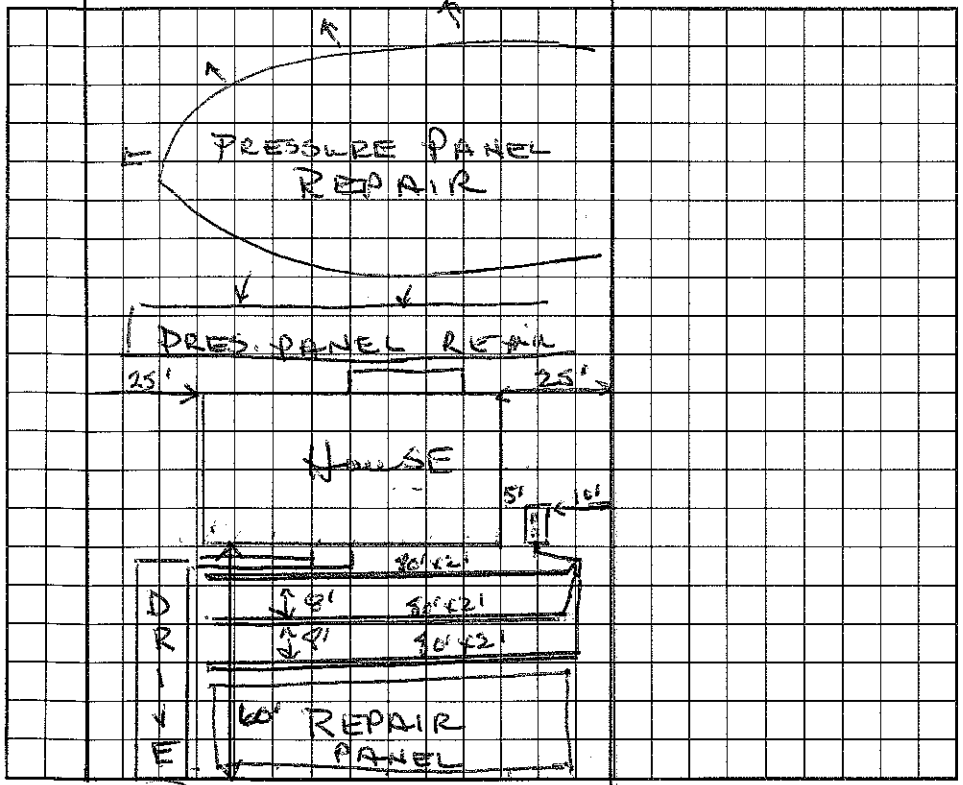

AS BUILT SKETCH

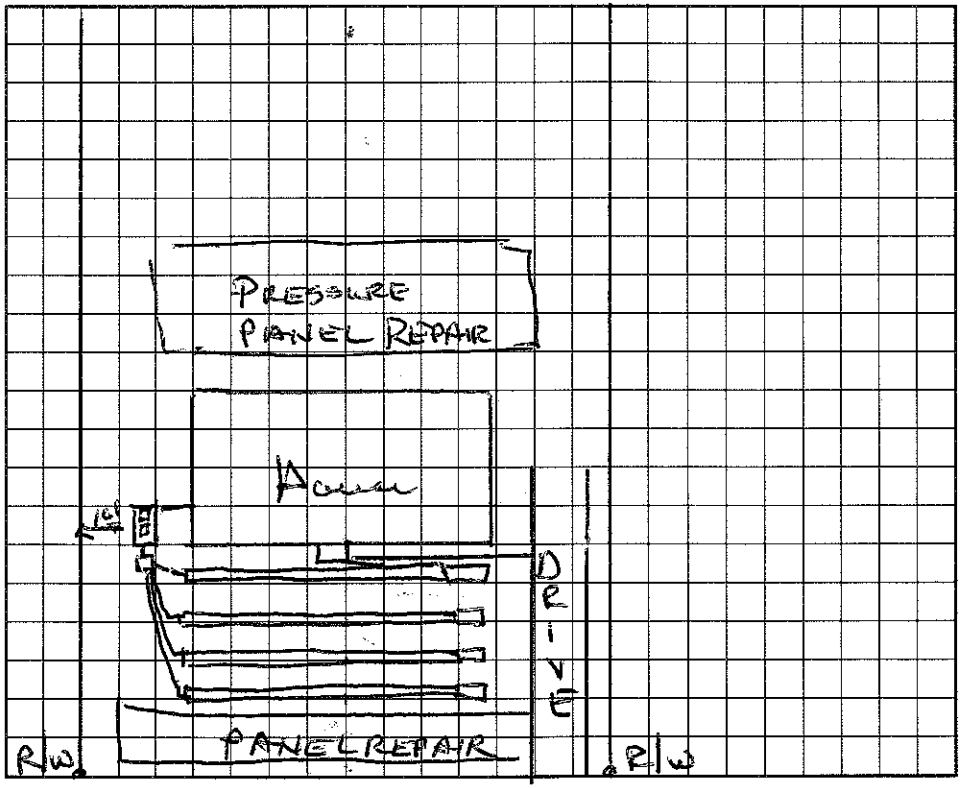

I understand that this permit can be suspended or revoked if any false information is supplied toward securing the permit/any unauthorized changes are made to the site/any unauthorized changes are made in the installation of the system. Improvement Permit is valid for 60 months from date of issuance.

Signed: [signature]

Improvement Permit by: Wesley Sparks R.S. date 10/26/93

Existing System Inspection by: ____ date ____

Installed by: F J Ervin

Certificate of Completion by: Wesley Sparks R.S. date 4/8/94

Operation Permit by: ____ date ____

HEALTH DEPT. COPY: WHITE INSPECTION COPY (FINAL): GREEN OWNER COPY (FINAL): YELLOW INSPECTION COPY (INITIAL): PINK OWNER COPY (INITIAL): GOLD