IREDELL COUNTY HEALTH DEPARTMENT

STATESVILLE 704-878-5305 MOORESVILLE 704-664-5281

IMPROVEMENT PERMIT / CERTIFICATE OF COMPLETION / OPERATION PERMIT / EXISTING SYSTEM INSPECTION

PROPERTY DESCRIPTION NO. 20355 DATE 2/27/95 TAX MAP NO. 4E-5-A-8 Watershed: ☐ Yes ☐ No

OWNER OR CONTRACTOR Keith Carroll Builders PHONE: Business 464-1155 Home 4659-46-1379

ADDRESS 795 French Bell Rd. Mt Ulla, NC. 28115

LOCATION last lot on (L) of cul de sac.

SUBDIVISION LAUREL WOOD BLOCK / SECTION ____ LOT 8 LOT AREA 1.19 Ac SITE CLASS. P DESIGN FLOW 360 L.T.A.R. 3

Septic Tank: 1000 Gallons; STB 194 Bellinger Date 4-28-95

Pump Tank: ____ Gallons; PT ____ Date ____

Pump Make: ____ Model ____ Serial No. ____

Nitrification Field: No Fields 1 Square Feet 400 Linear Feet 225 ✱

No Lines 3 Trench Width 24" Max Trench Bottom Depth 36" Gravel Depth ____

☑ New System ☐ Repair System Type: I, II, ☑ III, IV, V, VI

System Description: 16" PPBPS

Repair System Description: SAME

Maintenance Agreement Required: ☐ Yes ☑ No

☑ House/Mod. Home No. Bedrooms 3

☐ Mobile Home No. Bathrooms 2.5

☐ Business No. Employees ____

☐ Other ____


☐ Slab ☐ Crawl Space ☑ Basement w/plumbing ☐ Basement wo/plumbing

Water Supply: ☑ Individual ☐ Community ☐ Public


Comments:

Comments: 4th line 50'x2' of panel added due to line 2 being 400 close to line 1

INITIAL SITE SKETCH

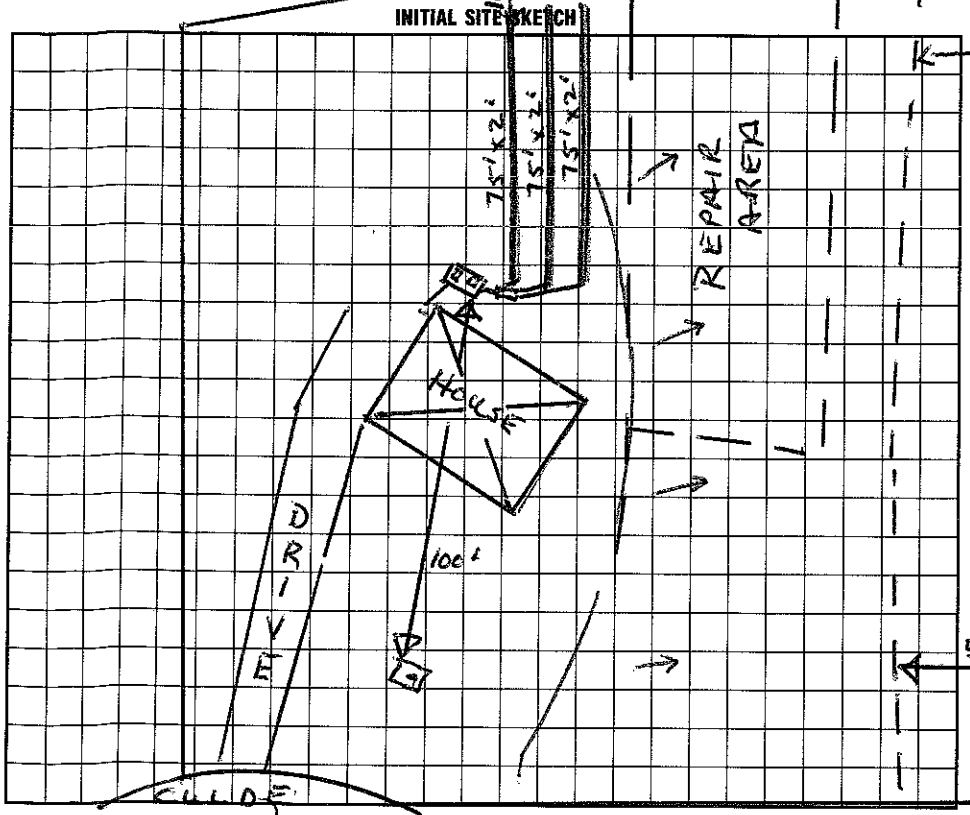

AS BUILT SKETCH

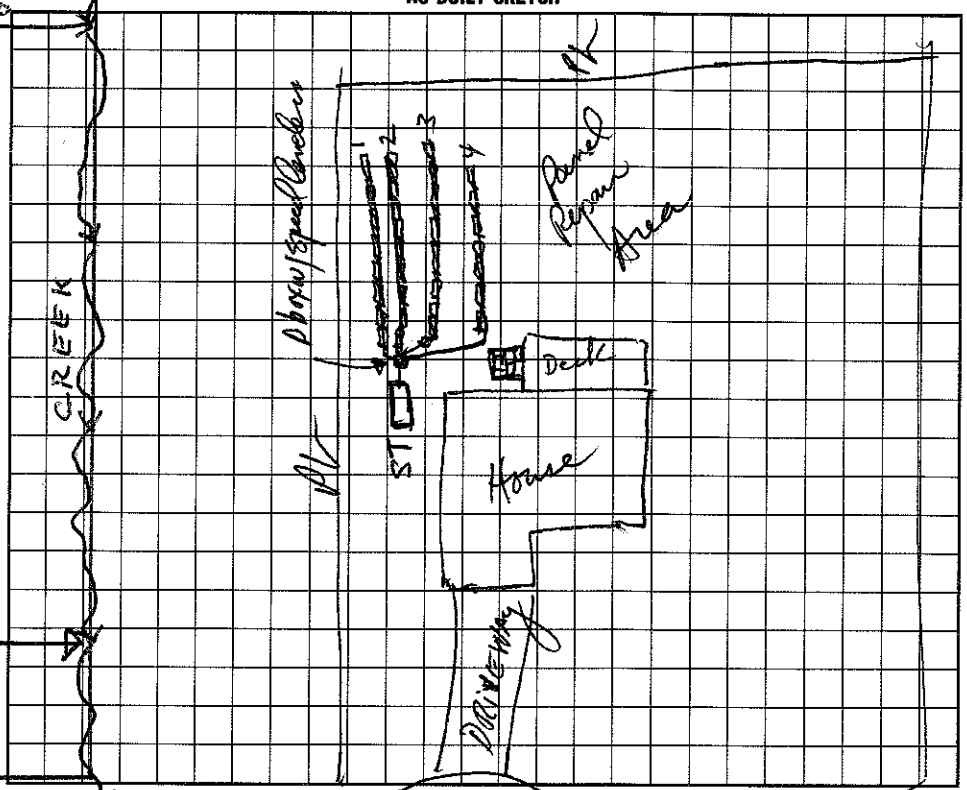

I understand that this permit can be suspended or revoked if any false information is supplied toward securing the permit/any unauthorized changes are made to the site/any unauthorized changes are made in the installation of the system. Improvement Permit is valid for 60 months from date of issuance.

Signed: Keith Carroll

Improvement Permit by: Wilbur Sparks R.S. date 2/27/95

Existing System Inspection by: ____ date ____

Installed by: J Crain cul-USAE

Certificate of Completion by: ____ date ____

Operation Permit by: [illegible] R.S. date 10/16/95

HEALTH DEPT. COPY: WHITE INSPECTION COPY (FINAL): GREEN OWNER COPY (FINAL): YELLOW INSPECTION COPY (INITIAL): PINK OWNER COPY (INITIAL): GOLD