IREDELL COUNTY HEALTH DEPARTMENT

STATESVILLE 704-878-5305 MOORESVILLE 704-664-5281

IMPROVEMENT PERMIT / CERTIFICATE OF COMPLETION / OPERATION PERMIT / EXISTING SYSTEM INSPECTION

PROPERTY DESCRIPTION NO. 17258 DATE 10/26/93 TAX MAP NO. 4E A4 Watershed: ☑ Yes ☐ No

OWNER OR CONTRACTOR KEITH CARROLL PHONE: Business 664-1155 ~~Home~~ 459-46-1619

ADDRESS PO BOX 431 MT MOURNE, NC. 28123

LOCATION WESTMERE LAND RD, 115' N TR TR ON EQUESTRIAN TO 6th lot on (L)

SUBDIVISION LAURELWOOD BLOCK / SECTION 1 LOT 6 LOT AREA 20,227 Ft² SITE CLASS. P DESIGN FLOW 360 L.T.A.R. .25-.3

Septic Tank: 1000 Gallons; STB 358 ACP Date 11-17-93
Pump Tank: ____ Gallons; PT ____ Date ____
Pump Make: ____ Model ____ Serial No. ____
Nitrification Field: No Fields 1 Square Feet 1200 Linear Feet 240
No Lines 3 Trench Width 2' Max Trench Bottom Depth 29" ~~Gravel~~ Stone Depth 6"

☑ New System ☐ Repair System Type: I, II, III, IV, V, VI
System Description: PPBPS 16"
Repair System Description: PPBPS 16"
Maintenance Agreement Required: ☐ Yes ☑ No


☑ House/Mod. Home No. Bedrooms 3
☐ Mobile Home No. Bathrooms 2
☐ Business No. Employees ____
☐ Other ____
☐ Slab ☑ Crawl Space ☐ Basement w/plumbing ☐ Basement wo/plumbing

Water Supply:
☐ Individual
☑ Community
☐ Public

Comments: .5 REDUCTION FOR PPBPS USE
TRENCH DEPTH IMPORTANT.

Comments:

INITIAL SITE SKETCH

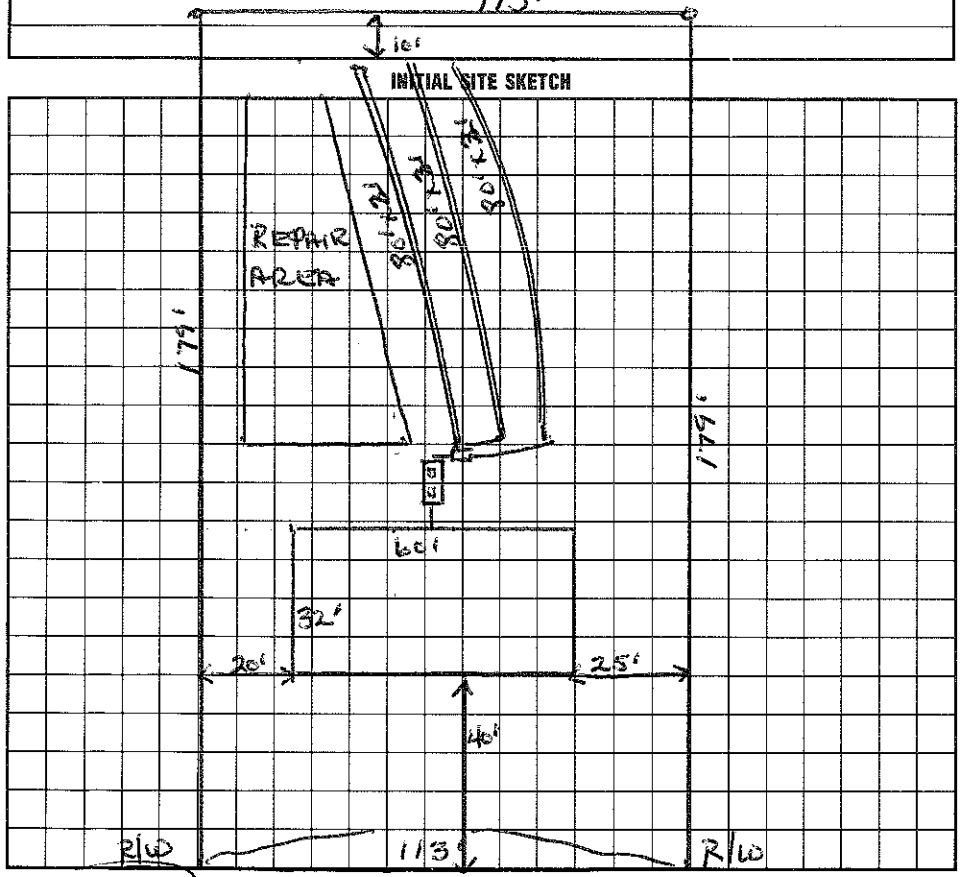

AS BUILT SKETCH

I understand that this permit can be suspended or revoked if any false information is supplied toward securing the permit/any unauthorized changes are made to the site/any unauthorized changes are made in the installation of the system. Improvement Permit is valid for 60 months from date of issuance.

Signed: EQUESTRIAN DR.

Improvement Permit by: Wesley Sparks R.S. date 10/26/93

Existing System Inspection by: ____ date ____

Installed by: F T Ervin

Certificate of Completion by: Wesley Sparks R.S. date 1/10/94

Operation Permit by: ____ date ____

HEALTH DEPT. COPY: WHITE INSPECTION COPY (FINAL): GREEN OWNER COPY (FINAL): YELLOW INSPECTION COPY (INITIAL): PINK OWNER COPY (INITIAL): GOLD