IREDELL COUNTY HEALTH DEPARTMENT

STATESVILLE 704-878-5305 MOORESVILLE 704-664-5281

IMPROVEMENT PERMIT / AUTHORIZATION TO CONSTRUCT / OPERATION PERMIT / EXISTING SYSTEM INSPECTION

PERMIT# 134976 PIN# 4659474604 DATE 6-26-06

OWNER OR APPLICANT Ronald & Teresa Wishon PHONE: Business 704-896-1085 Home 704-528-0131

ADDRESS 210 Westmoreland Rd Mooresville 28115

LOCATION 21N TR Westmoreland Rd at corner of Curtis Dr (210 Westmoreland)

SUBDIVISION NA 1 BLOCK / SECTION ____ LOT ____ LOT AREA 1.452 SITE CLASS. PS DESIGN FLOW 480gpd L.T.A.R. .13 gpd/ft²

Septic Tank: 1000 Gallons; STB 794 Date 7-3-06
Pump Tank: ____ Gallons; PT ____ Date ____
Pump Make: ____ Model ____ Serial No. ____
Nitrification Field: No Fields 1 Square Feet 1600 Linear Feet 535
No Lines 5@107' Trench Width 36" Max Trench Bottom Depth 36"

☒ New System ☐ Repair ☐ Expansion System Type: I (II) III IV V VI
System Description: Conventional gravity
Repair System Description: Conventional gravity
Maintenance Agreement Required: ☐ Yes ☒ No

☒ House/Mod. Home No. Bedrooms 4
☐ Mobile Home No. Persons ____
☐ Business No. Employees ____
☐ Other ____

Water Supply: ☐ Individual ☐ Public ☒ Community


Gravel Depth 12" ☒ Gravity ☐ Pressure ☐ Slab ☒ Crawl Space ☐ Basement w/plumbing ☐ Basement wo/plumbing

Comments/Conditions: ① Owners choose to install new system rather than repair existing & expanding

Comments/Conditions: ③ An accepted system may also be used ← flow splitter such as Zoeller


(2) Shave Berms Before Installing System

INITIAL SITE SKETCH

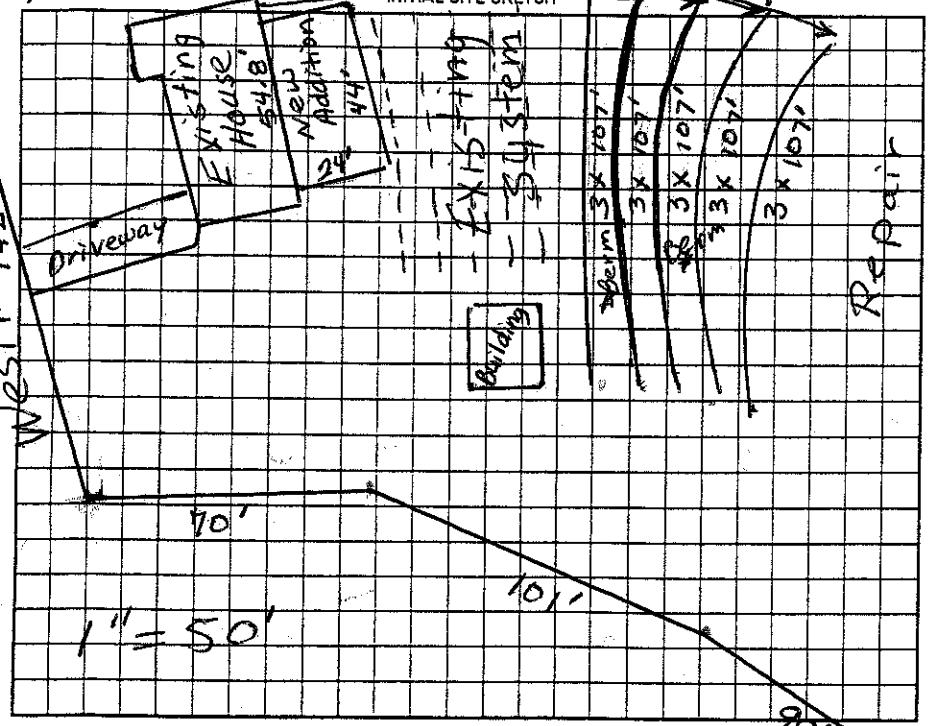

AS BUILT SKETCH

5T w/risers red polylok filter

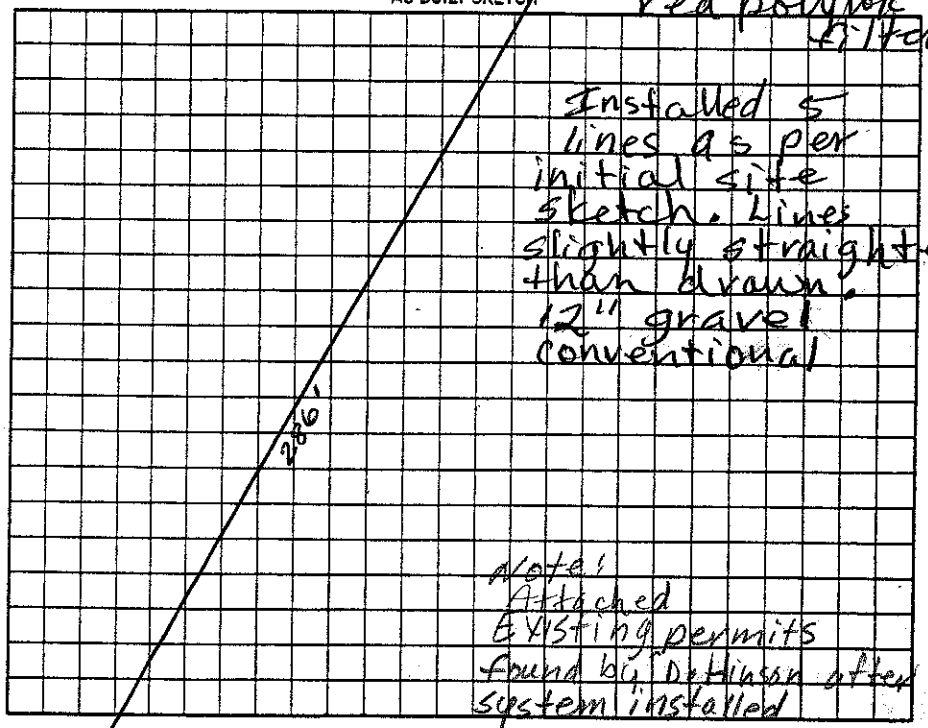

Note: Attached Existing permits found by Dettinger after system installed

Permit can be suspended or revoked if any false information is supplied toward securing the permit/any unauthorized changes are made to the site/any unauthorized changes are made in the installation of the system. Improvement Permit with plat valid without expiration. ☐ Improvement Permit with site plan valid for sixty months ☒ Authorization to Construct is valid for a period equal to that of Improvement Permit – not to exceed sixty months.

Signed: Teresa Wishon date 6-26-06 Installed by: RJ Errin

Improvement Permit by: Judy Melville date 6-26-06 Operation Permit by: Judy Melville date 8-22-06

Authorization to Construct by: Judy Melville date 6-26-06 Existing System Inspection by: ____ date ____

HEALTH DEPT. COPY: WHITE OWNER COPY (FINAL): YELLOW OWNER COPY (INITIAL): PINK