IREDELL COUNTY HEALTH DEPARTMENT

STATESVILLE 704-878-5305 MOORESVILLE 704-664-5281

IMPROVEMENT PERMIT / AUTHORIZATION TO CONSTRUCT / OPERATION PERMIT / EXISTING SYSTEM INSPECTION

PERMIT# 106971 PIN# 4659-47-5775 DATE 6/25/02

OWNER OR CONTRACTOR Robert Shearer PHONE: Business Home 704-799-3178

ADDRESS 1032 Patterson Farm Rd Mooresville NC 28115

LOCATION 115N, TR West Moreland, on Rt

SUBDIVISION BLOCK / SECTION LOT LOT AREA 2.0 AC SITE CLASS. PS DESIGN FLOW 360 L.T.A.R. 0.3

Septic Tank: 1000 Gallons; STB 794 Date 6/11/02
Pump Tank: Gallons; PT Date
Pump Make: Model Serial No.
Nitrification Field: No Fields 1 Square Feet 1200 Linear Feet 400 PLUS
No Lines 4 @ 100' Trench Width 36" Max Trench Bottom Depth 36" Gravel Depth 12"

☒ New System ☐ Repair System Type: I II III IV V VI
System Description: Gravity Conventional
Repair System Description: Same
Maintenance Agreement Required: ☐ Yes ☒ No


☐ House/Mod. Home No. Bedrooms 3
☒ Mobile Home No. Bathrooms 2
☐ Business No. Employees
☐ Other
☐ Slab ☒ Crawl Space ☐ Basement w/plumbing ☐ Basement wo/plumbing

Water Supply: ☒ Individual ☐ Public ☐ Community

Comments:/Conditions:

Comments:/Conditions:

INITIAL SITE SKETCH

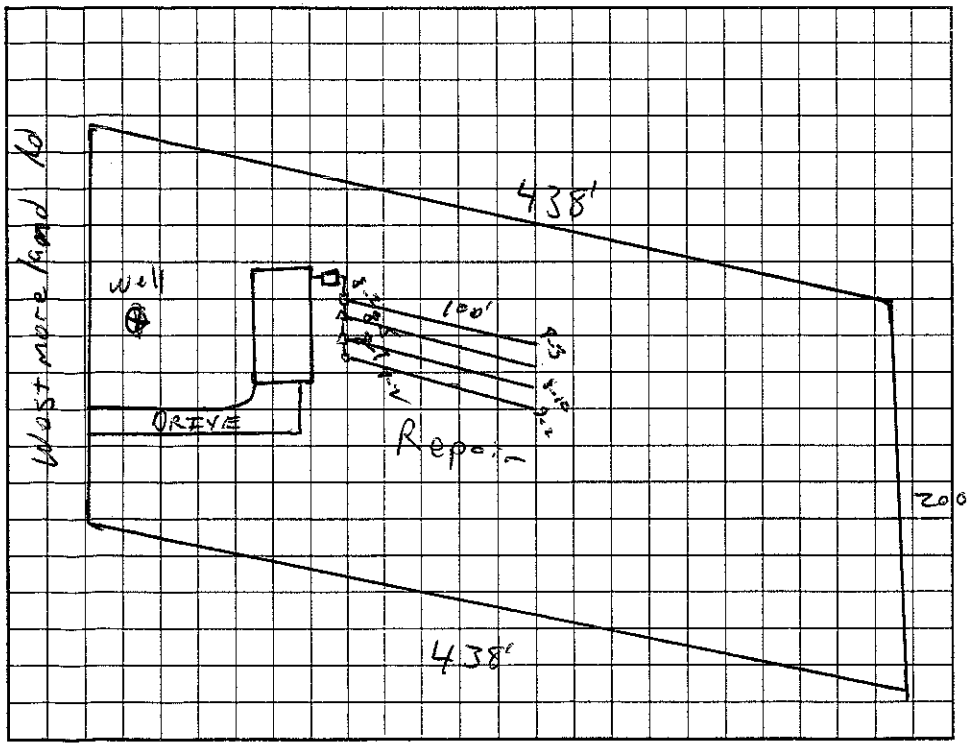

AS BUILT SKETCH

Permit can be suspended or revoked if any false information is supplied toward securing the permit/any unauthorized changes are made to the site/any unauthorized changes are made in the installation of the system. Improvement Permit with plat valid without expiration. Improvement Permit with site plan valid for sixty months. Authorization to Construct is valid for a period equal to that of Improvement Permit – not to exceed sixty months.

Signed: A. A'Hale date 7/1/02 Installed by: Bobby Backhoe Service

Improvement Permit by: RS date 6/25/02 Operation Permit by: Wesley Sparks RS. date 9/11/02

Authorization to Construct by: RS date 6/25/02 Existing System Inspection by: date

HEALTH DEPT. COPY: WHITE OWNER COPY (FINAL): YELLOW OWNER COPY (INITIAL): PINK