IREDELL COUNTY HEALTH DEPARTMENT

STATESVILLE 704-878-5305 MOORESVILLE 704-664-5281

IMPROVEMENT PERMIT / AUTHORIZATION TO CONSTRUCT / OPERATION PERMIT / EXISTING SYSTEM INSPECTION

H.30

PERMIT # A Repair PIN # 4659480320 DATE 3-11-2011

OWNER or APPLICANT James Phifer PHONE: Business 7045285861 Home: 658-4791

OWNER or APPLICANT ADDRESS 130 Cardinal Ln

LOCATION / DIRECTIONS Hwy 115/US 21 N TR Westmoreland TL Cardinal Ln on right #130

SUBDIVISION Cardinal Acres BLOCK / SECTION II LOT # 40 LOT AREA _____ DESIGN FLOW 360gpd T.A.R. _____

Install New ST

Septic Tank 1000 Gallons: STB 760 Date 10-2-11

Pump Tank _____ Gallons: P T _____ Date _____

Pump Make _____ Model _____ Serial # _____

Nitrification Field No Fields 1 No Lines Existing Linear Feet _____

Trench Width _____ Max. Trench Bottom Depth _____ Gravel Depth _____

☐ New System ☒ Repair ☐ Expansion System Type I (II) III IV V VI

System Description: Gravity - Conventional

Repair System Description: _____

Maintenance Agreement Required ☐ YES ☐ NO

☒ GRAVITY ☐ PRESSURE

☒ Residence No. Bedrooms 3

☐ Business No. Persons _____

☐ Other No. Employees _____

☐ Slab ☐ Crawl Space


☐ Basement w/plumbing ☐ Basement w/o plumbing

Water Supply: ☐ Private ☐ Public ☒ Community

Comments / Conditions: Keep New ST 15 Ft from basement wall (if possible) Must "properly" abandon old ST Could not locate original permit.

Comments / Conditions: ☆ Note: Verify Drainfield location while excavating ST. & Size

INITIAL SITE SKETCH

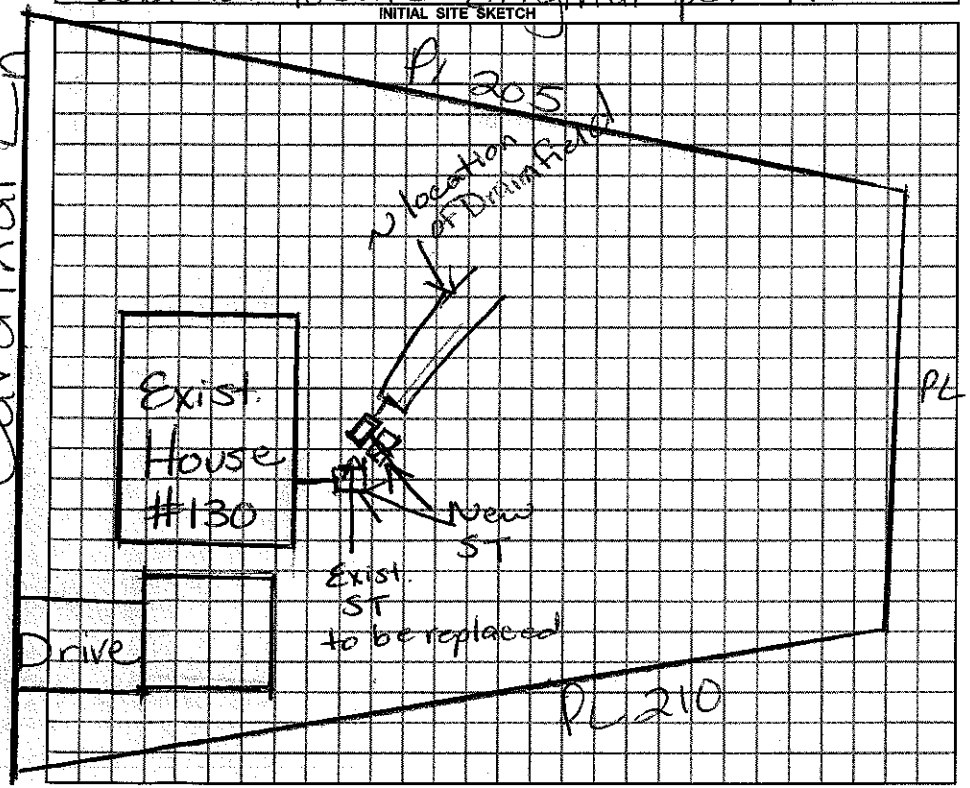

AS BUILT SKETCH

Permit can be suspended or revoked if any false information is supplied toward securing the permit / any unauthorized changes are made to the site / any unauthorized changes are made in the installation of the system.

☐ *IMPROVEMENT PERMIT w/ plat valid without expiration.* ☐ *IMPROVEMENT PERMIT w / site plan valid for 60 mos.* ☐ *AUTHORIZATION TO CONSTRUCT valid for period equal to IMPROVEMENT PERMIT-not to exceed 60 mo.*

Owner / Applicant Signature: James E Phifer Date 3-11-11

Improvement Permit by: Maina M. Dotson RS Date 3/11/2011

Authorization to Construct by: Maina M. Dotson RS Date 3/11/2011

YOU SHOULD CONTACT A LOCATOR SERVICE PRIOR TO ANY EXCAVATION.

Installed by: A-1 Backhoe RS

Operation Permit by: Maina M. Dotson Date: 3/22/11

Existing System Inspected by: _____ Date: _____

WHITE COPY Environmental Health YELLOW COPY (Final) Owner / Applicant PINK COPY (Initial) Owner / Applicant