IREDELL COUNTY HEALTH DEPARTMENT

Authorization to Construct

STATESVILLE 704-878-5305 MOORESVILLE 704-664-5281

11:00 1 35

IMPROVEMENT PERMIT / ~~CERTIFICATE OF COMPLETION~~ / OPERATION PERMIT / EXISTING SYSTEM INSPEC

PROPERTY DESCRIPTION NO. 24683 DATE 7/25/97 TAX MAP NO. 4F-1-A-33

OWNER OR CONTRACTOR SARA L. SLOAT ~~PHONE: Business~~ PIN# 4659-49-0040 Home

ADDRESS 131 PINE MEADOW MOORESVILLE Watershed: ☐ Yes ☐ ~~No~~

LOCATION 21 N. TO WESTMORELAND - TL CARDINAL LN - 1ST LOT ON RT BEFORE - CUL-DE-SAC

SUBDIVISION CARDINAL ACRES BLOCK / SECTION LOT 33 LOT AREA SITE CLASS. PS DESIGN FLOW 360 L.T.A.R. .4

Septic Tank: 1000 Gallons; STB 794 Date 9/24/97

Pump Tank: Gallons; PT Date

Pump Make: Model Serial No.

Nitrification Field: No Fields 1 Square Feet 900 Linear Feet 300

No Lines 3@100 Trench Width 36" Max Trench Bottom Depth 36" Gravel Depth 12"

☑ New System ☐ Repair System Type: I, II, III, IV, V, VI

System Description: GRAVITY CONVENTIONAL

Repair System Description: PANEL

Maintenance Agreement Required: ☐ Yes ☑ ~~No~~

☑ ~~House/Mod. Home~~ No. Bedrooms 3

☐ Mobile Home No. Bathrooms 2

☐ Business No. Employees

☐ Other


☐ Slab ☑ Crawl Space ☐ Basement w/plumbing ☐ Basement wo/plumbing

Water Supply: ☑ ~~Individual~~ ☐ Community ☐ Public


Comments:

Comments:

INITIAL SITE SKETCH

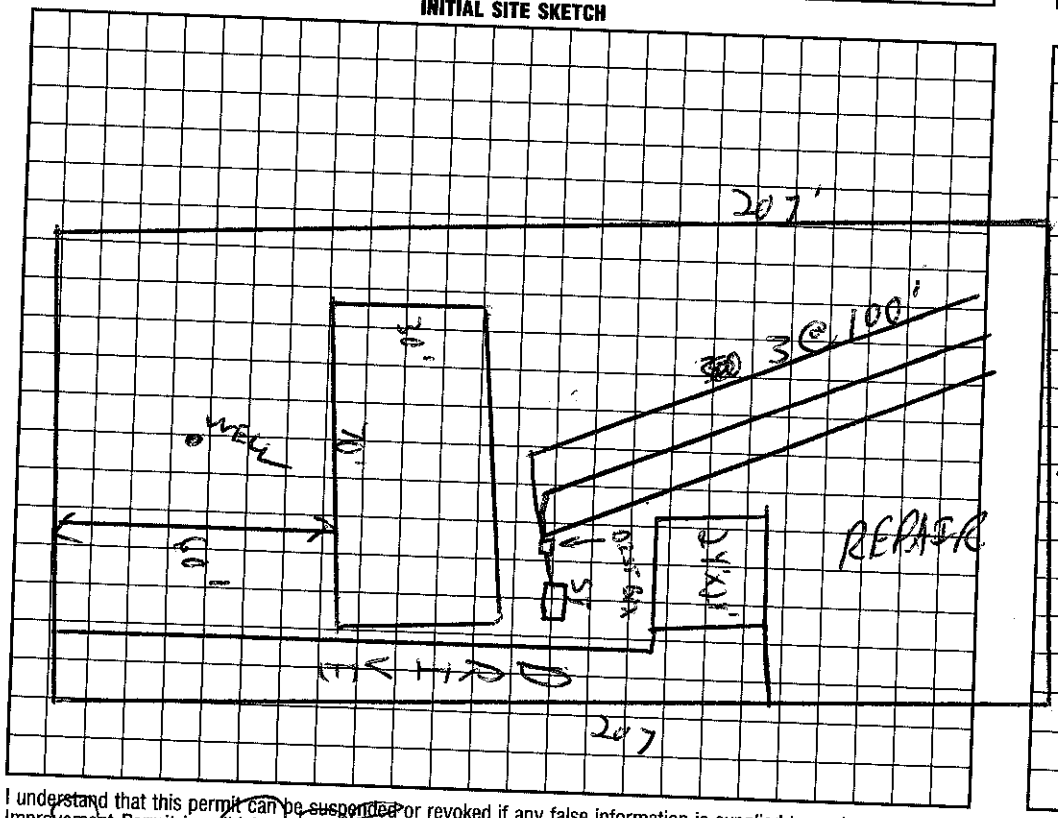

AS BUILT SKETCH

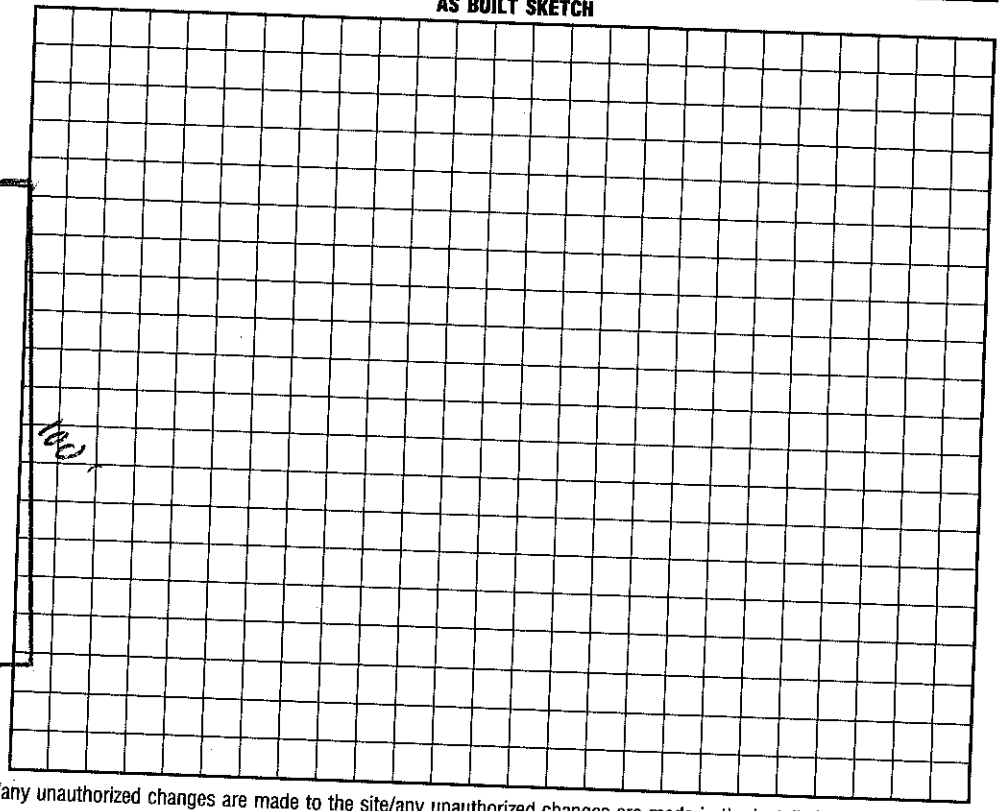

I understand that this permit can be ~~suspended~~ or revoked if any false information is supplied toward securing the permit/any unauthorized changes are made to the site/any unauthorized changes are made in the installation of the system. Improvement Permit is valid for 60 months from date of issuance.

Signed: Sara L. Sloat

Improvement Permit by: C. Ray Zeno date 7/25/97

~~Existing System Inspection by:~~ Authorization C. Ray Zeno date 7/25/97

Installed by: FJ ERVIN

Certificate of Completion by: date

Operation Permit by: C. Ray Zeno date 11/24/97

HEALTH DEPT. COPY: WHITE INSPECTION COPY (FINAL): GREEN OWNER COPY (FINAL): YELLOW INSPECTION COPY (INITIAL): ~~PINK~~ OWNER COPY (INITIAL): GOLD