IREDELL COUNTY HEALTH DEPARTMENT

Authorization to Construct

STATESVILLE 704-878-5305 MOORESVILLE 704-664-5281

IMPROVEMENT PERMIT / ~~CERTIFICATE OF COMPLETION~~ / OPERATION PERMIT / EXISTING SYSTEM INSPECTION

PROPERTY DESCRIPTION NO. 069254 DATE 9/25/97 TAX MAP NO. 4659 50 5698 Watershed: ☒ Yes ☐ No

OWNER OR CONTRACTOR Douglas Jones PHONE: Business _____ Home 892-1548

ADDRESS Milo Home Mooresville, NC 28115

LOCATION 115 N TL Milo Lane to cul de sac, straight on drive to MH

SUBDIVISION MILOSAVLJEVIC BLOCK / SECTION _____ LOT 6 LOT AREA ~3.4 AC SITE CLASS PS DESIGN FLOW 360 L.T.A.R. .3

Septic Tank: 1000 Gallons; STB 1012 Date 7/22/97

Pump Tank: _____ Gallons; PT _____ Date _____

Pump Make: _____ Model _____ Serial No. _____

Nitrification Field: No Fields 1 Square Feet 1200 Linear Feet 400

No Lines 3 Trench Width 36" Max Trench Bottom Depth 30" Gravel Depth 12"

☒ New System ☐ Repair System Type: I, II, (III), IV, V, VI

System Description: GRAV - CONVENTIONAL

Repair System Description: SAME

Maintenance Agreement Required: ☐ Yes ☐ No

☒ House/Mod. Home No. Bedrooms 3

☐ Mobile Home No. Bathrooms 2

☐ Business No. Employees _____

☐ Other _____

☐ Slab ☒ Crawl Space ☐ Basement w/plumbing ☐ Basement wo/plumbing


Water Supply: ☒ Individual ☐ Community ☐ Public

Comments:


Comments:

400

INITIAL SITE SKETCH

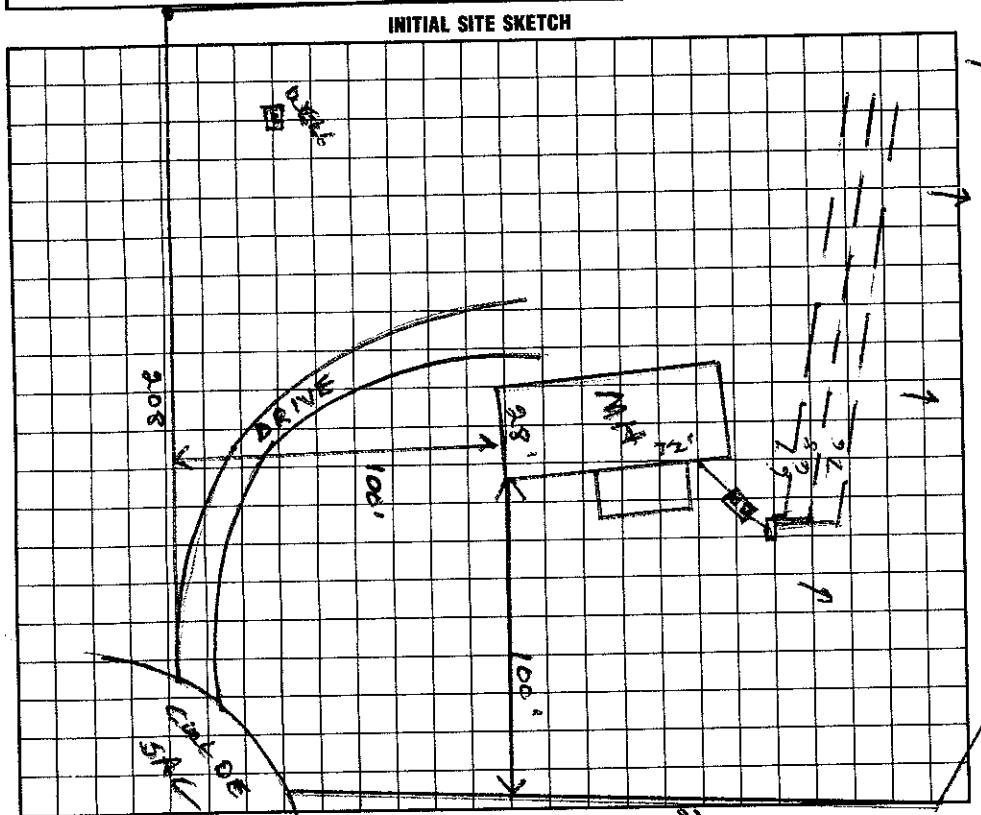

AS BUILT SKETCH

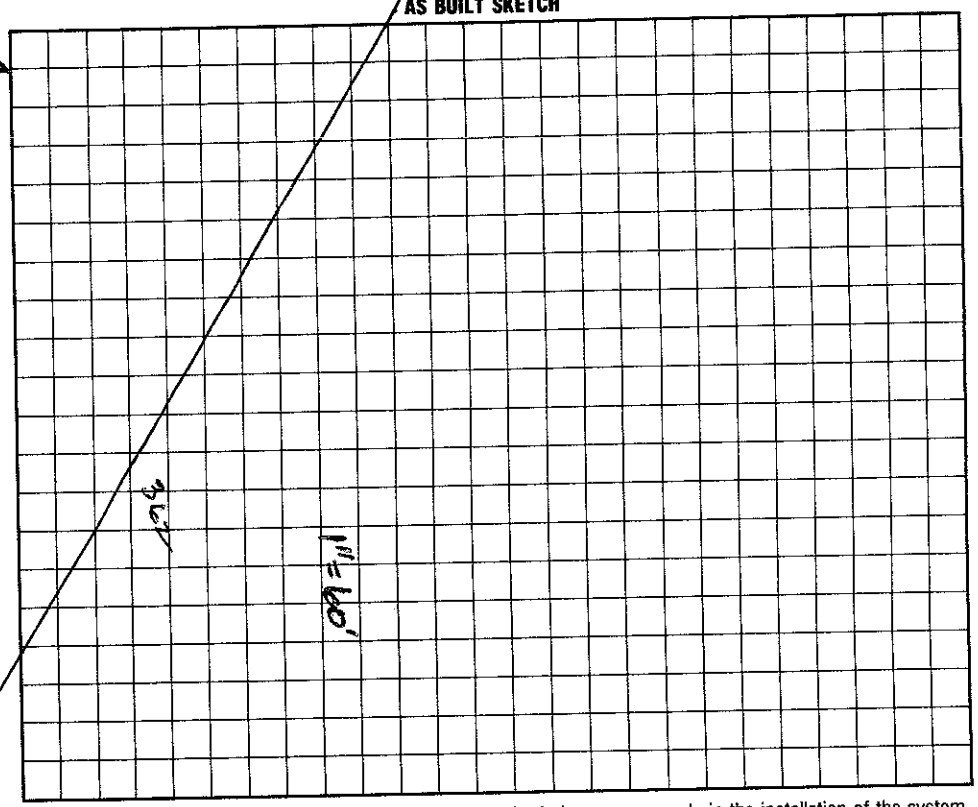

I understand that this permit can be suspended or revoked if any false information is supplied toward securing the permit/any unauthorized changes are made to the site/any unauthorized changes are made in the installation of the system. Improvement Permit is valid for 60 months from date of issuance.

Signed: X Russell Olson

Improvement Permit by: Wesley Sparks R.S. date 9/25/97

Existing System Inspection by: Wesley Sparks R.S. date 9/25/97

Installed by: A 1 BACKHOE

Certificate of Completion by: _____ date _____

Operation Permit by: C. [signature] date 10/1/97

HEALTH DEPT. COPY: WHITE INSPECTION COPY (FINAL): GREEN OWNER COPY (FINAL): YELLOW INSPECTION COPY (INITIAL): PINK OWNER COPY (INITIAL): GOLD