IREDELL COUNTY HEALTH DEPARTMENT

Authorization to Construct

STATESVILLE 704-878-5305 MOORESVILLE 704-664-5281

IMPROVEMENT PERMIT / ~~CERTIFICATE OF COMPLETION~~ / OPERATION PERMIT / EXISTING SYSTEM INSPECTION

PROPERTY DESCRIPTION NO. 06940 DATE 9/25/97 TAX MAP NO. 4559 50 3968

OWNER OR CONTRACTOR Donald Hatfield PHONE: Business Home 528-3320 Watershed: [X] Yes [ ] No

ADDRESS 144 Milo Ln. Mooresville, NC.

LOCATION 115 N TL MILO LANE TO LAST LOT ON (R) BEFORE CUL DE SAC 4659-50-3968

SUBDIVISION MILOSAVIJEVIC BLOCK / SECTION LOT 1 LOT AREA ~1 AC SITE CLASS. PS DESIGN FLOW 360 L.T.A.R. 3

Septic Tank: 1000 Gallons; STB 1012 Date 7/22/97

Pump Tank: Gallons; PT Date

Pump Make: Model Serial No.

Nitrification Field: No Fields 1 Square Feet 1200 Linear Feet 400

No Lines 3 Trench Width 36" Max Trench Bottom Depth 30" Gravel Depth 12"

[X] New System [ ] Repair System Type: I, (II), III, IV, V, VI

System Description: GRAV-CONV

Repair System Description: SAME

Maintenance Agreement Required: [ ] Yes [ ] No

[X] House/Mod. Home No. Bedrooms 3

[ ] Mobile Home No. Bathrooms 2

[ ] Business No. Employees

[ ] Other

[ ] Slab [ ] Crawl Space [ ] Basement w/plumbing [ ] Basement wo/plumbing


Water Supply: [X] Individual [ ] Community [ ] Public

Comments:


CUL DE SAC

Comments:

INITIAL SITE SKETCH

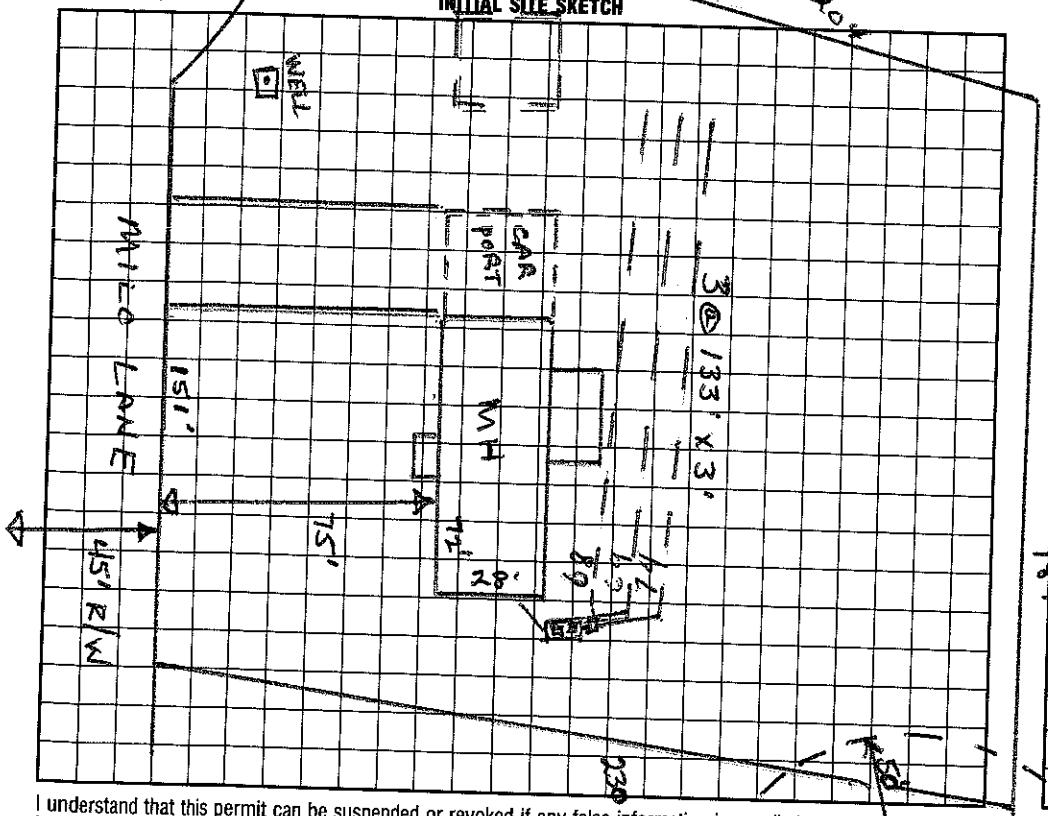

AS BUILT SKETCH

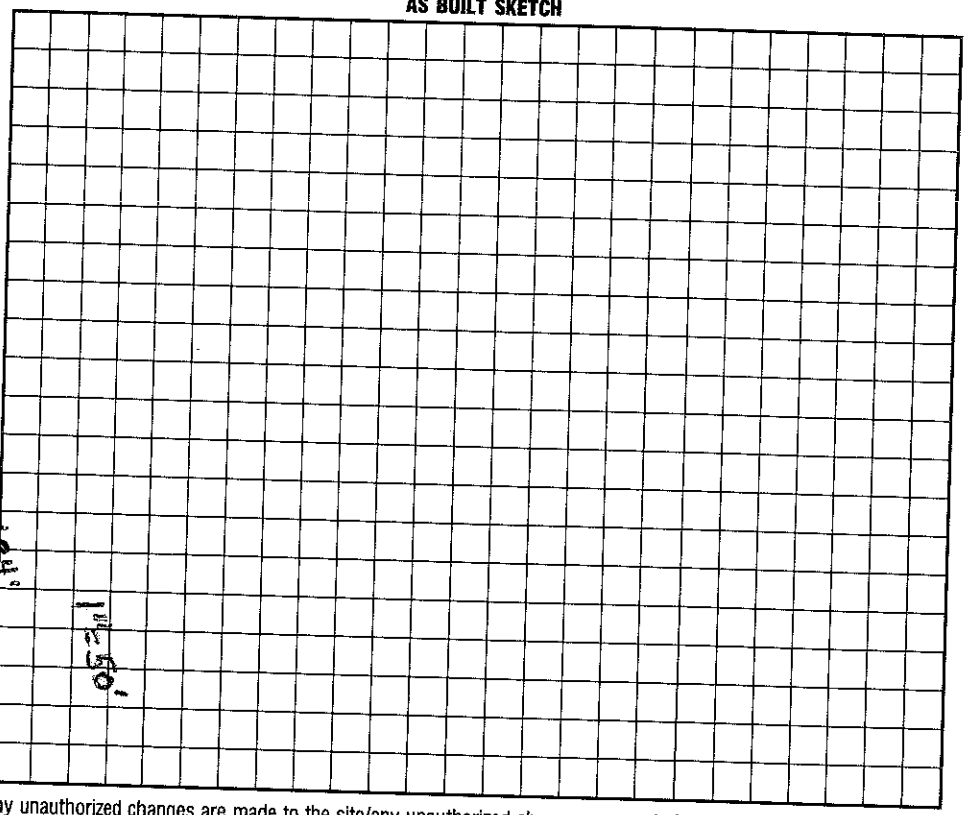

I understand that this permit can be suspended or revoked if any false information is supplied toward securing the permit/any unauthorized changes are made to the site/any unauthorized changes are made in the installation of the system. Improvement Permit is valid for 60 months from date of issuance.

Signed: Russell Wilson

Improvement Permit by: Wesley Sparks RS. date 9/25/97 Well

~~Existing System Inspection~~ by: Wesley Sparks RS. date 9/25/97

Installed by: A-1 BACKHOE

Certificate of Completion by: date

Operation Permit by: date 10-1-97

HEALTH DEPT. COPY: WHITE INSPECTION COPY (FINAL): GREEN OWNER COPY (FINAL): YELLOW INSPECTION COPY (INITIAL): PINK OWNER COPY (INITIAL): GOLD