CW

ICHD - ENVIRONMENTAL HEALTH DIVISION

Statesville Office (704) 878-5305 | Mooresville Office (704) 660-3625 PERMIT # AP 2022-5522

SEPTIC: IMPROVEMENT PERMIT / AUTHORIZATION TO CONSTRUCT / OPERATION PERMIT / EXISTING SYSTEM

PIN # 4659 -- 51 -- 2345 ✓

APPLICANT/OWNER: Rex Shook APPLICANT ADDRESS: 166 White Pine Dr Mooresville 28115

SITE ADDRESS: 123 White Pine Dr Mooresville 28115 ✓ PHONE: 828-308-7587 ALT. PHONE –


SITE DIRECTIONS: (L) Garner Bagnal, I-77S to exit 42, (R) White Pine Dr SAP CONTROLLED: ☐ YES ☑ NO

SUBDIVISION: – SECTION: – LOT # – LOT AREA: 3.51 Ac DESIGN FLOW: Ext L.T.A.R.: Ext


Septic Tank Ext (gal)	STB	Date	☐ New System ☐ Repair ☐ Expansion System Type: I (II) III IV V VI	☑ Residence	No. Bedrooms 2	Water Supply
Pump Tank (gal)	PT	Date	System Description: Terracotta Pipe	☐ Business	No. Persons 4	☐ Private
Pump Make	Model	Serial #	Repair System Description:	☐ Other	No. Employees	☐ Public
# Nitrification Fields Ext	# Lines Ext	Linear Ft Ext	Maintenance Agreement Required: ☐ YES ☑ NO	☐ Slab	☐ Crawl Space	☐ Community
Trench Width Ext	Trench Bottom Depth(Low side) Ext	Gravel Depth Ext	☑ GRAVITY ☐ PRESSURE	☐ Basement w/plumbing	☐ Basement w/o plumbing	

Comments / Conditions: Keep house 10ft sewer from septic tank and 25ft sewer from well. System appeared to be functioning during inspection.

INITIAL SITE SKETCH

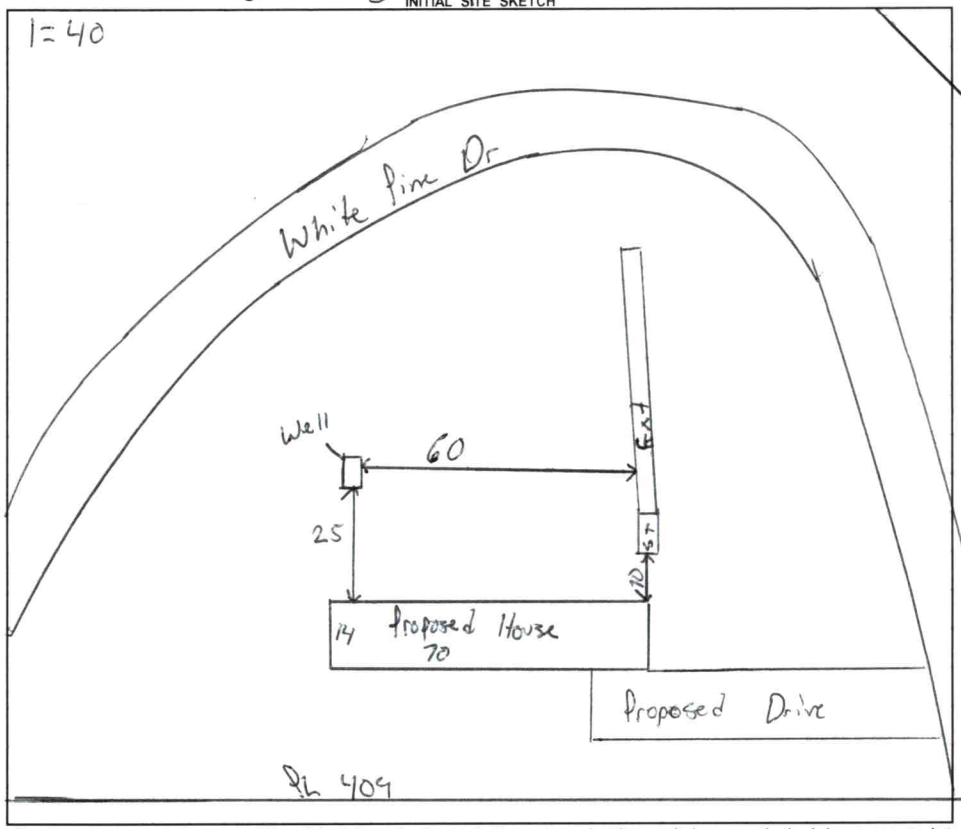

AS BUILT SKETCH

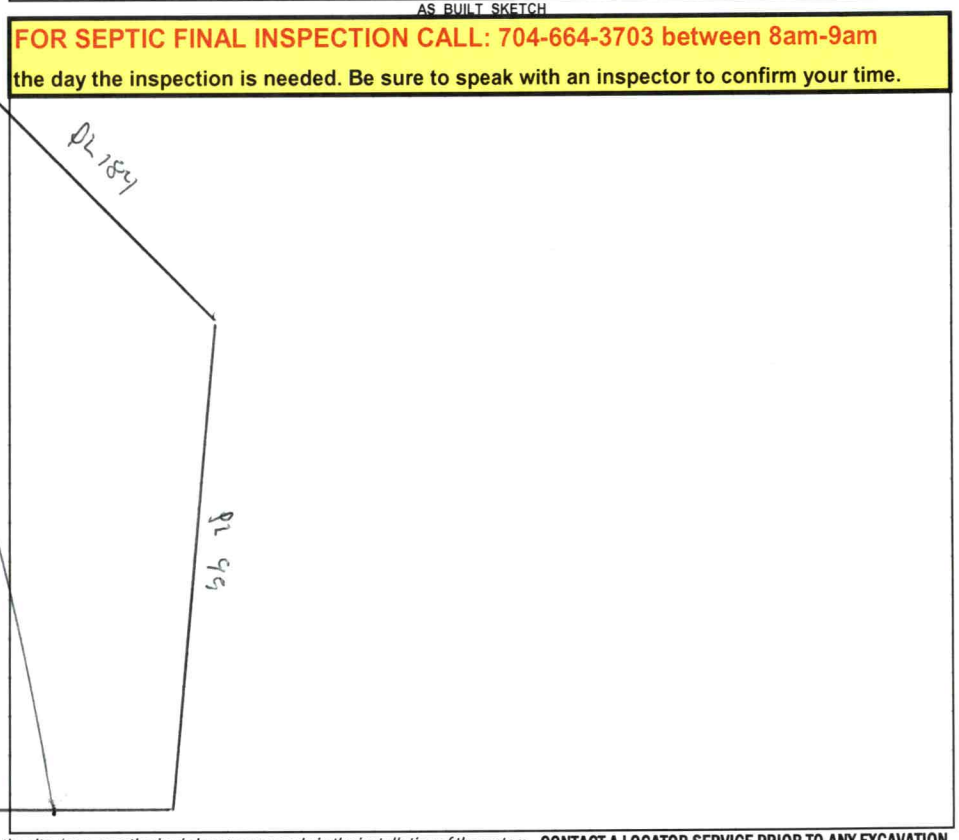

FOR SEPTIC FINAL INSPECTION CALL: 704-664-3703 between 8am-9am
the day the inspection is needed. Be sure to speak with an inspector to confirm your time.

Permit can be suspended or revoked if any false information is supplied toward securing the permit / any unauthorized changes are made to the site / any unauthorized changes are made in the installation of the system. **CONTACT A LOCATOR SERVICE PRIOR TO ANY EXCAVATION**

☐ **IMPROVEMENT PERMIT** ***with plat*** *valid without expiration.* ☐ **IMPROVEMENT PERMIT** ***with site plan*** *valid for 60 mos.* ☐ **AUTHORIZATION TO CONSTRUCT** *valid for period equal to IMPROVEMENT PERMIT--not to exceed 60 mo.*

Owner / Applicant Signature: Online Signature Date: Installed by:


IMPROVEMENT PERMIT by: Date: OPERATION PERMIT by: Date:

AUTHORIZATION TO CONSTRUCT by: Date: Existing System Inspected by: Date: 10/4/22

FOR SEPTIC FINAL INSPECTION: CALL 704-664-3703 between 8am-9am the day the inspection is needed.

123 White Pine Dr.
Mooresville


Acknowledgement Of
Plans Submittal ONLY!
Date 12/28/22
Date

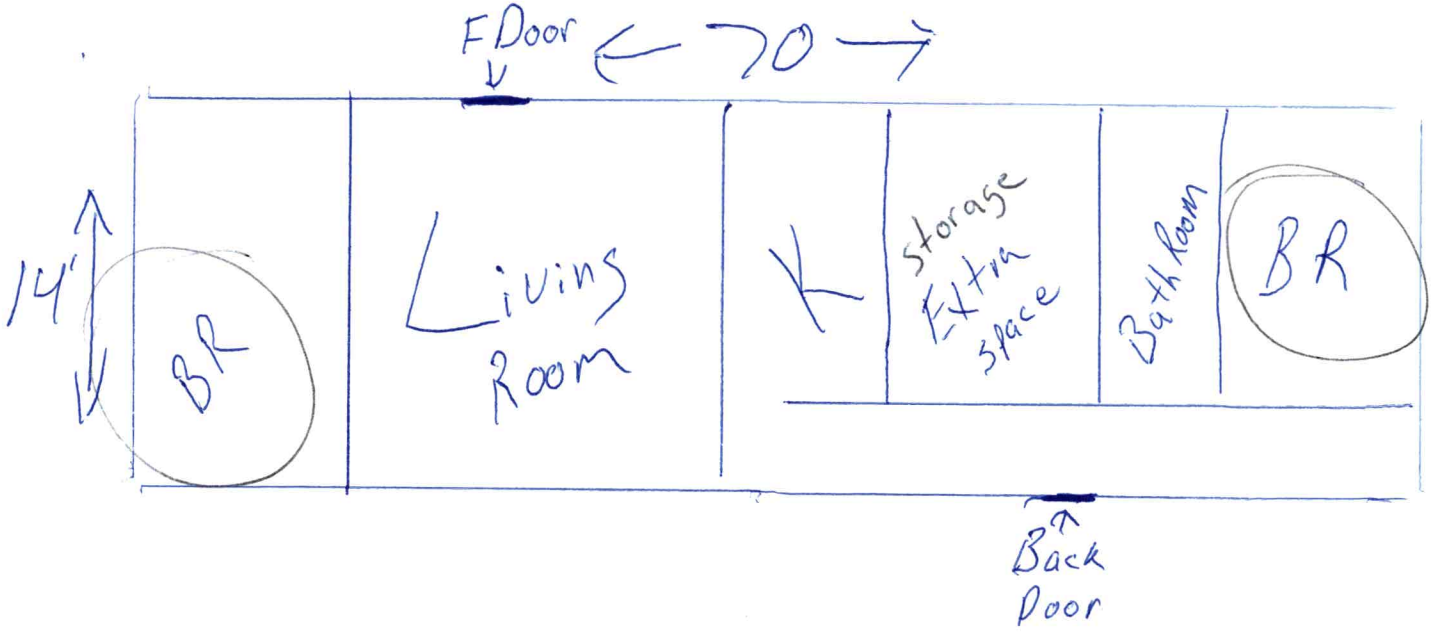

Ref Shook
12-28-22

IREDELL COUNTY HEALTH DEPARTMENT
ENVIRONMENTAL HEALTH DIVISION
PAGE 2: *SITE PLAN WORKSHEET*

SEE THE "SAMPLE SITE PLAN" BELOW. *INCOMPLETE SITE PLANS WILL BE RETURNED TO YOU FOR COMPLETION AND MAY RESULT IN A DELAY IN THE ISSUANCE OF YOUR SEPTIC SYSTEM PERMIT!!!*

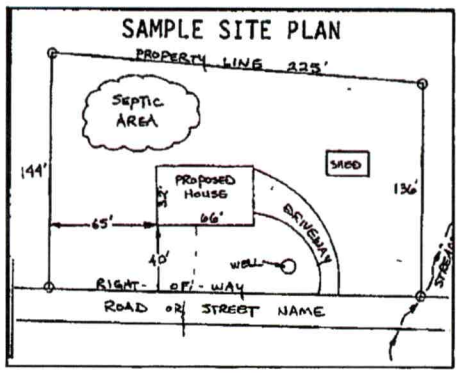

Place an (X) beside each item as you complete the site plan:


( ) **Property Line measurements are clearly identified**
( ) **All proposed structures are indicated**
( ) **Front and side setbacks from property line**
( ) **Preferred driveway location and well location**
( ) **Area you prefer your septic system to be placed**
( ) **North arrow, or other sufficient indicator of direction**

Circle N/A on the following if appropriate:

Location of septic systems and wells within 100' of your property	**N/A**
Location of easements and rights of ways on your property	**N/A**
Location of any designated wetlands on the property	**N/A**

USE THIS SPACE TO DRAW YOUR SITE PLAN

Show: proposed house or business footprint, wells, water lines, patios, pools and decks, and any other item that will occupy space on the site

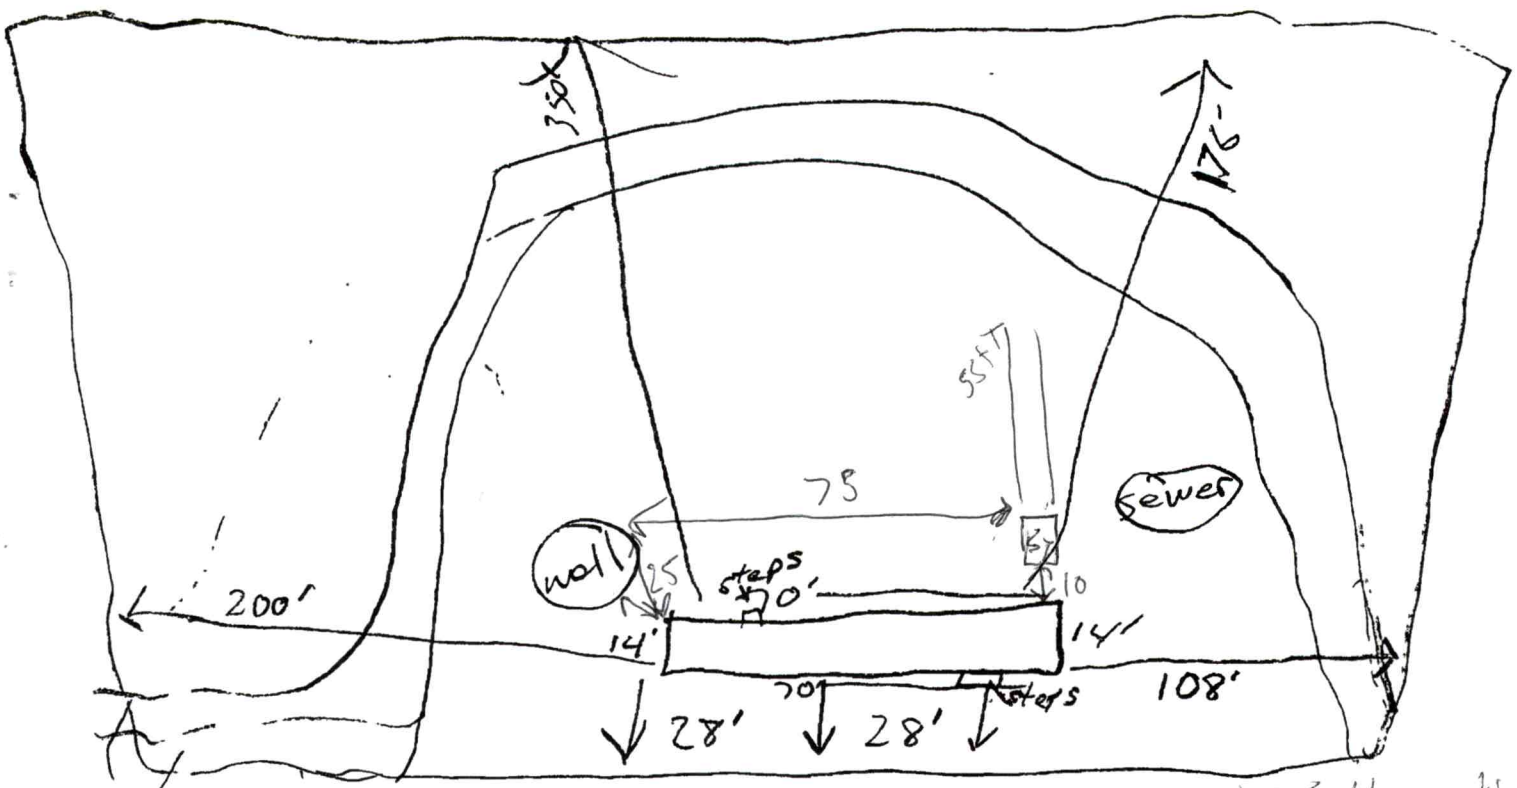

Tesra Pike

123 White Pine D

note note: System working during inspection.

Signature: Ray Shook
Property owner or owner's legal representative signature (SIGNATURE REQUIRED)

9-26-22
DATE

- Put something above tank to divert water