CSWP-2023-15133

ICHD - ENVIRONMENTAL HEALTH DIVISION

Statesville Office (704) 878-5305 | Mooresville Office (704) 660-3625 | PERMIT # AP

SEPTIC: IMPROVEMENT PERMIT / AUTHORIZATION TO CONSTRUCT / OPERATION PERMIT / EXISTING SYSTEM

PIN # 4659 -- 51 -- 2345

APPLICANT/OWNER: Rex Shook | APPLICANT ADDRESS: 116 White Pine Dr. Mooresville NC 28115

SITE ADDRESS: 123 White Pine Dr. Mooresville, NC 28115 | PHONE: 828-308-7687 | ALT. PHONE


SITE DIRECTIONS: (N) NC 115/21 → (L) White Pine → lot on (L) | SAP CONTROLLED: [X] YES [ ] NO

SUBDIVISION: | SECTION: | LOT # | LOT AREA: 3.51 ac | DESIGN FLOW: 240 gpd | L.T.A.R.: EXISTING

Septic Tank 1000 (gal)	STB 760	Date 12-27-2022	[ ] New System [X] Repair [ ] Expansion	System Type: I (II) III IV V VI	[X] Residence	No. Bedrooms 2	Water Supply
Pump Tank (gal)	PT	Date	System Description: EXISTING		[ ] Business	No. Persons 4	[X] Private existing
Pump Make	Model	Serial #	Repair System Description: New Tank		[ ] Other	No. Employees	[ ] Public
# Nitrification Fields	# Lines	Linear Ft	Maintenance Agreement Required:	[ ] YES [X] NO	[ ] Slab	[X] Crawl Space	[ ] Community
Trench Width	Trench Bottom Depth(Low side) EXISTING	Gravel Depth		[X] GRAVITY [ ] PRESSURE	[ ] Basement w/plumbing		[ ] Basement w/o plumbing

Comments / Conditions: Pump, crush, & fill existing tank. Set new tank to achieve fall - replace distribution device if needed.

INITIAL SITE SKETCH

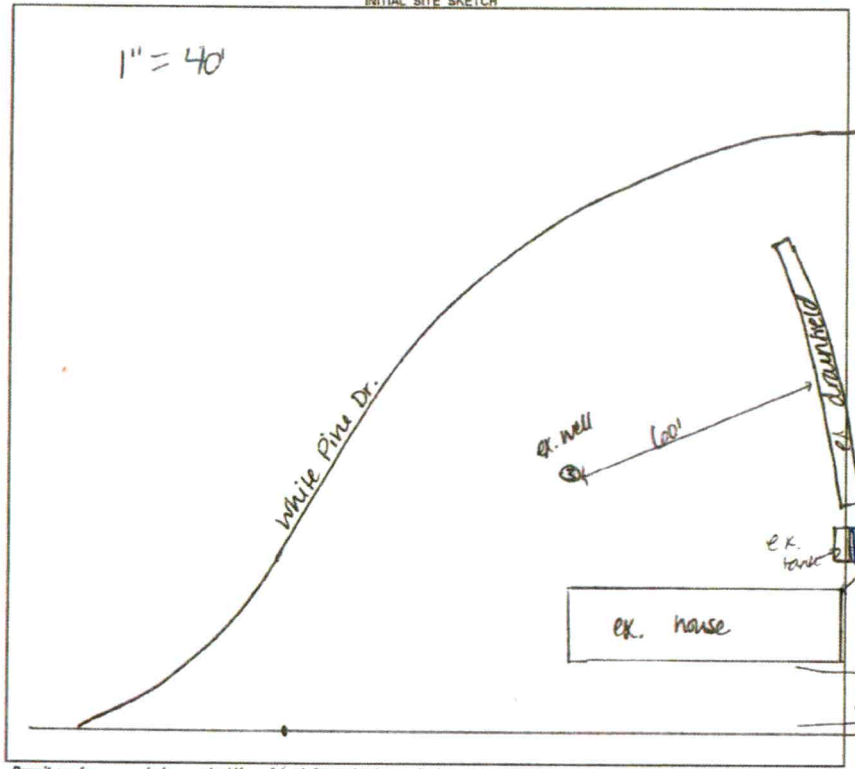

AS BUILT SKETCH

FOR SEPTIC FINAL INSPECTION CALL: 704-664-3703 between 8am-9am the day the inspection is needed. Be sure to speak with an inspector to confirm your time.

CEMENT TILE IN DRAINLINES APPEARED TO BE INTACT AT TIME OF INSPECTION BCW 2-27-2023

INSTALLED AS SHOWN

Permit can be suspended or revoked if any false information is supplied toward securing the permit / any unauthorized changes are made to the site / any unauthorized changes are made in the installation of the system. **CONTACT A LOCATOR SERVICE PRIOR TO ANY EXCAVATION**

[ ] **IMPROVEMENT PERMIT** *with plat valid without expiration.* [X] **IMPROVEMENT PERMIT** *with site plan valid for 60 mos.* [ ] **AUTHORIZATION TO CONSTRUCT** *valid for period equal to IMPROVEMENT PERMIT--not to exceed 60 mo.*

Owner / Applicant Signature: online signature | Date: | Installed by: LENTZ WASTEWATER

IMPROVEMENT PERMIT by: D.Webers | Date: 2/10/23 | OPERATION PERMIT by: Bryant L. Webb | Date: 2-27-2023

AUTHORIZATION TO CONSTRUCT by: D.Webers | Date: 2/10/23 | Existing System Inspected by: | Date:

FOR SEPTIC FINAL INSPECTION: CALL 704-664-3703 between 8am-9am the day the inspection is needed.

USWP - 2023-15133

ICHD - ENVIRONMENTAL HEALTH DIVISION

Statesville Office (704) 878-5305 | Mooresville Office (704) 660-3625 PERMIT # AP

SEPTIC: IMPROVEMENT PERMIT / AUTHORIZATION TO CONSTRUCT / OPERATION PERMIT / EXISTING SYSTEM

PIN # 4659 -- 51 -- 2345

APPLICANT/OWNER: Rex Shook APPLICANT ADDRESS: 1616 White Pine Dr. Mooresville NC 28115

SITE ADDRESS: 123 White Pine Dr. Mooresville, NC 28115 PHONE: 828-308-7687 ALT. PHONE


SITE DIRECTIONS: (N) NC 115/21 → (L) White Pine → lot on (L) SAP CONTROLLED: [X] YES [ ] NO

SUBDIVISION: SECTION: LOT # LOT AREA: 3.51 ac DESIGN FLOW: 240 gpd L.T.A.R.: EXISTING

Septic Tank	1000 (gal)	STB 760	Date 12-27-2022	[ ] New System [X] Repair [ ] Expansion	System Type: (II) III IV V VI	[X] Residence	No. Bedrooms	2	Water Supply
Pump Tank	(gal)	PT	Date	System Description: EXISTING		[ ] Business	No. Persons	4	[X] Private (existing)
Pump Make	Model		Serial #	Repair System Description: New Tank		[ ] Other	No. Employees		[ ] Public
# Nitrification Fields	# Lines EXISTING		Linear Ft	Maintenance Agreement Required: [ ] YES [X] NO		[ ] Slab	[X] Crawl Space		[ ] Community
Trench Width	Trench Bottom Depth(Low side)		Gravel Depth	[X] GRAVITY [ ] PRESSURE		[ ] Basement w/plumbing		[ ] Basement w/o plumbing	

Comments / Conditions: Pump, crush, & fill existing tank. Set new tank to achieve fall - replace distribution device if needed.

INITIAL SITE SKETCH

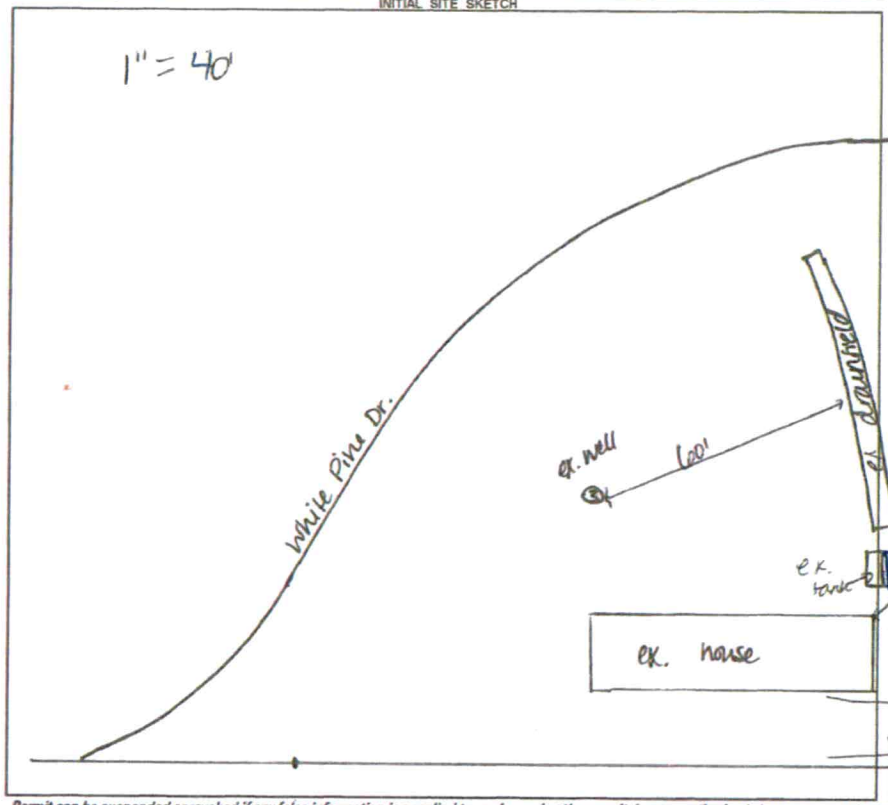

AS BUILT SKETCH

FOR SEPTIC FINAL INSPECTION CALL: 704-664-3703 between 8am-9am the day the inspection is needed. Be sure to speak with an inspector to confirm your time.

CEMENT TILE IN DRAINLINES APPEARED TO BE INTACT AT TIME OF INSPECTION BCW 2-27-2023

INSTALLED AS SHOWN

Permit can be suspended or revoked if any false information is supplied toward securing the permit / any unauthorized changes are made to the site / any unauthorized changes are made in the installation of the system. **CONTACT A LOCATOR SERVICE PRIOR TO ANY EXCAVATION**

[ ] **IMPROVEMENT PERMIT** *with plat valid without expiration.* [X] **IMPROVEMENT PERMIT** *with site plan valid for 60 mos.* [ ] **AUTHORIZATION TO CONSTRUCT** *valid for period equal to IMPROVEMENT PERMIT--not to exceed 60 mo.*

Owner / Applicant Signature: online signature Date: Installed by: LENTZ WASTEWATER

IMPROVEMENT PERMIT by: D.Weber Date: 2/10/23 OPERATION PERMIT by: Bryant L. Witter Date: 2-27-2023

AUTHORIZATION TO CONSTRUCT by: D.Weber Date: 2/10/23 Existing System Inspected by: Date:

FOR SEPTIC FINAL INSPECTION: CALL 704-664-3703 between 8am-9am the day the inspection is needed.

CW

ICHD - ENVIRONMENTAL HEALTH DIVISION

Statesville Office (704) 878-5305 | Mooresville Office (704) 660-3625

SEPTIC: IMPROVEMENT PERMIT / AUTHORIZATION TO CONSTRUCT / OPERATION PERMIT / EXISTING SYSTEM

PERMIT # AP 2022-5522

PIN # 4654 -- 51 -- 2345

APPLICANT/OWNER: Rex Sheets

APPLICANT ADDRESS: 166 White Pine Dr Mooresville 28115

SITE ADDRESS: 123 White Pine Dr Mooresville 28115

PHONE: 828-308-7557

ALT. PHONE: –

SITE DIRECTIONS: Gunner Beginal, I-77S to exit 42, (R) White Pine Dr

SAP CONTROLLED: ☐ YES ☑ NO

SUBDIVISION: –

SECTION: – LOT # – LOT AREA: 3.51 Ac

DESIGN FLOW: Ext L.T.A.R.: Ext


Septic Tank Ext	(gal)	STB	Date	☐ New System ☐ Repair ☐ Expansion	System Type: I II III IV V VI
Pump Tank	(gal)	PT	Date	System Description: Irrigation Pipe	
Pump Make	Model		Serial #	Repair System Description:	
# Nitrification Fields Ext	# Lines Ext		Linear Ft Ext	Maintenance Agreement Required: ☐ YES ☑ NO	
Trench Width Ext	Trench Bottom Depth(Low side) Ext		Gravel Depth Ext	☑ GRAVITY ☐ PRESSURE	

☑ Residence No. Bedrooms 2
☐ Business No. Persons 4
☐ Other No. Employees
☐ Slab ☐ Crawl Space
☐ Basement w/ plumbing ☐ Basement w/o plumbing

Water Supply: ☐ Private ☐ Public ☐ Community

Comments / Conditions: Keep house 10ft+ away from septic tank and 75ft+ away from well. System appeared to be functioning during inspection.

INITIAL SITE SKETCH

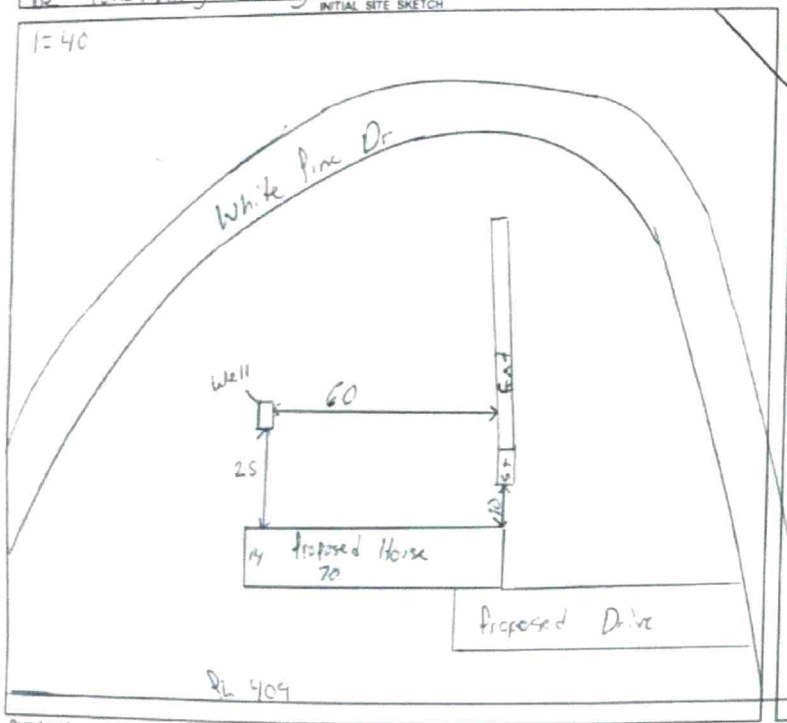

AS BUILT SKETCH

FOR SEPTIC FINAL INSPECTION CALL: 704-664-3703 between 8am-9am the day the inspection is needed. Be sure to speak with an inspector to confirm your time.

Permit can be suspended or revoked if any false information is supplied toward securing the permit / any unauthorized changes are made to the site / any unauthorized changes are made in the installation of the system. **CONTACT A LOCATOR SERVICE PRIOR TO ANY EXCAVATION**

☐ **IMPROVEMENT PERMIT** *with plat valid without expiration.* ☐ **IMPROVEMENT PERMIT** *with site plan valid for 60 mos.* ☐ **AUTHORIZATION TO CONSTRUCT** *valid for period equal to IMPROVEMENT PERMIT--not to exceed 60 mo.*

Owner / Applicant Signature: Online Signature Date: _____

IMPROVEMENT PERMIT by: _____ Date: _____

AUTHORIZATION TO CONSTRUCT by: _____ Date: _____

Installed by: _____ Date: _____

OPERATION PERMIT by: _____ Date: _____

Existing System Inspected by: [signature] Date: 10/4/22

FOR SEPTIC FINAL INSPECTION: CALL 704-664-3703 between 8am-9am the day the inspection is needed.

Pending eval - may need drainfield

IREDELL COUNTY DEPARTMENT OF ENVIRONMENTAL HEALTH

DOCUMENTATION TO AUTHORIZE AN OWNER'S LEGAL REPRESENTATIVE

(Check and sign only ONE of the options below)

☒ **1. * APPLICANT AND OWNER ARE THE SAME. * (*Sign here*)** Rex Sloat

Applications for permits require the "signature of the owner or owner's legal representative" (15A NCAC 18A .1937). If the owner does not sign the application himself or herself, they can submit any one of the following documents to designate their legal representative: *Power of Attorney; Real Estate Contract; Estate executor; Bankruptcy trustee; Court ordered guardianship*

In the absence of the above documentation, the property owner may provide the local health department with documentation that designates a legal representative. A property owner may:

Complete this form to document his or her legal representative, or provide his or her own form that contains the information in this form. If there are multiple property owners, then all property owners must sign the form that designates a legal representative.

By signing a form that designates a legal representative for purposes of 15A NCAC 18A .1937, the property owner authorizes that representative to act on their behalf in matters pertaining to the application and permitting process, including signing or receiving any application, document or permit. The owner retains full responsibility to meet all permit conditions specified by the local health department.

☐ **2.** I, _____, am the legal owner(s) of the property located at _____, identified as PIN (Parcel Identification Number) _____, located in Iredell County, North Carolina.

I do hereby authorize (**print legal representative/company name**) _____, _____, to act as an agent on my behalf in applying for/signing/obtaining any of the documents described below.

- Application for Improvement Permit (IP) / Authorization to Construct (AC)
- Improvement Permit (IP) / Authorization to Construct (AC)
- Application for soil-site evaluation (new/repair)
- Application/permit for private drinking water well/well abandonment
- Application for Compliance Inspection

I agree to abide by all decisions and/or conditions between the legal representative acting on my behalf and the Iredell County Department of Public Health, Environmental Health Division.

_____ _____

Signature of Owner(s) Date

Mooresville - Environmental Health
barbara.nebel@co.iredell.nc.us
Fax: 704-662-3239
610 E. Center Avenue, Mooresville, NC 28115

Statesville - Environmental Health
ronda.hart@co.iredell.nc.us
Fax: 704-871-3483
349 N. Center Street, Statesville, NC 28677

PERMIT SNAPSHOT REPORT OSWP-2023-15133 FOR IREDELL COUNTY

Permit Type	Environmental Health OSWP	**Project:**		**App Date:**	01/31/2023
Work Class:	EH Septic Improvement Permit Repair	**District:**	Iredell County	**Exp Date:**	NOT AVAILABLE
Status:	PRIORITY PERMIT	**Square Feet:**	0.00	**Completed:**	NOT COMPLETED
Valuation:	$0.00	**Assigned To:**	Wieberg, Danielle	**Approval Expire Date:**	
Description:	Replace tank and repair lines :				

Parcel: 4659512345.000 Main	**Address:** 123 White Pine Dr Main Mooresville, NC 28115	**Zone:** RA(Residential Agricultural District)

Applicant/Authorized Agent	Property Owner
Rex Shook	Rex Shook
166 White Pine Drive	166 White Pine Drive
Mooresville, NC 28115	Mooresville, NC 28115
Mobile: (828) 308-7587	Mobile: (828) 308-7587

Permit Custom Fields

How is your site plan being submitted	Custom Site Plan	Does the site contain any jurisdictional wetlands	No	Non-domestic Sewage Generated	No
Other Public Agency	No	Maximum Number of Bedrooms	2	Number of Occupants	4
Foundation Type	Crawl Space Foundation	Water Supply	Existing Well	Desired Septic System Type	Conventional (most common)
If other septic system type, please explain		Additional Unique Setbacks Apply	No		

Attachment File Name	Added On	Added By	Attachment Group	Notes
Signature_Rex_Shook_1/31/2023.jpg	01/31/2023 12:06	Shook, Rex		Uploaded via CSS
Owner Auth_v1.pdf	01/31/2023 12:11	COMEAUX, DEBRA	Available Online	Authorize to Act as Agent
Septic layout_v1.pdf	01/31/2023 12:11	COMEAUX, DEBRA	Available Online	Site Plan

Invoice No.	Fee	Fee Amount	Amount Paid
NOT INVOICED	Existing System Septic Repair Permit	$150.00	$0.00
	Total for Invoice NOT INVOICED	$150.00	$0.00
	Grand Total for Permit	**$150.00**	**$0.00**

Workflow Step / Action Name	Action Type	Start Date	End Date
Application Completeness Check v.1		01/31/2023 12:11	01/31/2023 12:11
Confirm application complete v.1	Generic Action		01/31/2023 12:11
Lot Readiness Verification v.1			
~~OSWP Septic Preliminary Site Visit v.1~~	Inspection		01/31/2023 12:12
OSWP Site Evaluation v.1	Inspection		
~~**Zoning Review v.1**~~			01/31/2023 12:12
~~Iredell County Zoning Approval v.1~~	Task		01/31/2023 12:12
~~Issue Invoice v.1~~	Generic Action		01/31/2023 12:12
~~Fees Paid v.1~~	Generic Action		01/31/2023 12:12
Assign v.1			
Case Assigned v.1	Generic Action		
Permit Ready v.1			
Issue Permit v.1			
Issue Invoice v.1	Generic Action		
Fees Paid v.1	Generic Action		