IREDELL COUNTY HEALTH DEPARTMENT

Authorization to Construct

STATESVILLE 704-878-5305 MOORESVILLE 704-664-5281

IMPROVEMENT PERMIT / CERTIFICATE OF COMPLETION / OPERATION PERMIT / EXISTING SYSTEM INSPECTION

PROPERTY DESCRIPTION NO. 22121 DATE 12/19/95 TAX MAP NO. 1Q B 43 Watershed: ☐ Yes ☒ No

OWNER OR CONTRACTOR Jennifer Lynn Dixon PHONE: Business ______ Home 663-6163

ADDRESS 158 Dixon Ln. Mooresville, NC 28115

LOCATION 115-21N to Milo Ln. on (R) before curve of road ~~4659-50-3968~~ 4659515238

SUBDIVISION MILOSAVLJEVIK BLOCK / SECTION 1 LOT 3 LOT AREA ~1 Ac SITE CLASS. PS DESIGN FLOW 360 L.T.A.R. .25

Septic Tank: 1000 Gallons; STB 821 Date 11-27-95
Pump Tank: — Gallons; PT — Date —
Pump Make: — Model — Serial No. —
Nitrification Field: No Fields 1 Square Feet 1440 Linear Feet 480
No Lines 4 Trench Width 36" Max Trench Bottom Depth 36" Gravel Depth 12"

☒ New System ☐ Repair System Type: I, (II), III, IV, V, VI
System Description: CONVENTIONAL GRAVITY
Repair System Description: SAME
Maintenance Agreement Required: ☐ Yes ☒ No

☐ House/Mod. Home No. Bedrooms 3
☒ Mobile Home No. Bathrooms 2
☐ Business No. Employees ______
☐ Other ______


☐ Slab ☒ Crawl Space ☐ Basement w/plumbing ☐ Basement wo/plumbing

Water Supply:
☒ Individual
☐ Community
☐ Public

Comments:

Comments: Home and well not located at time of inspection. Keep both required distances from septic System.

INITIAL SITE SKETCH

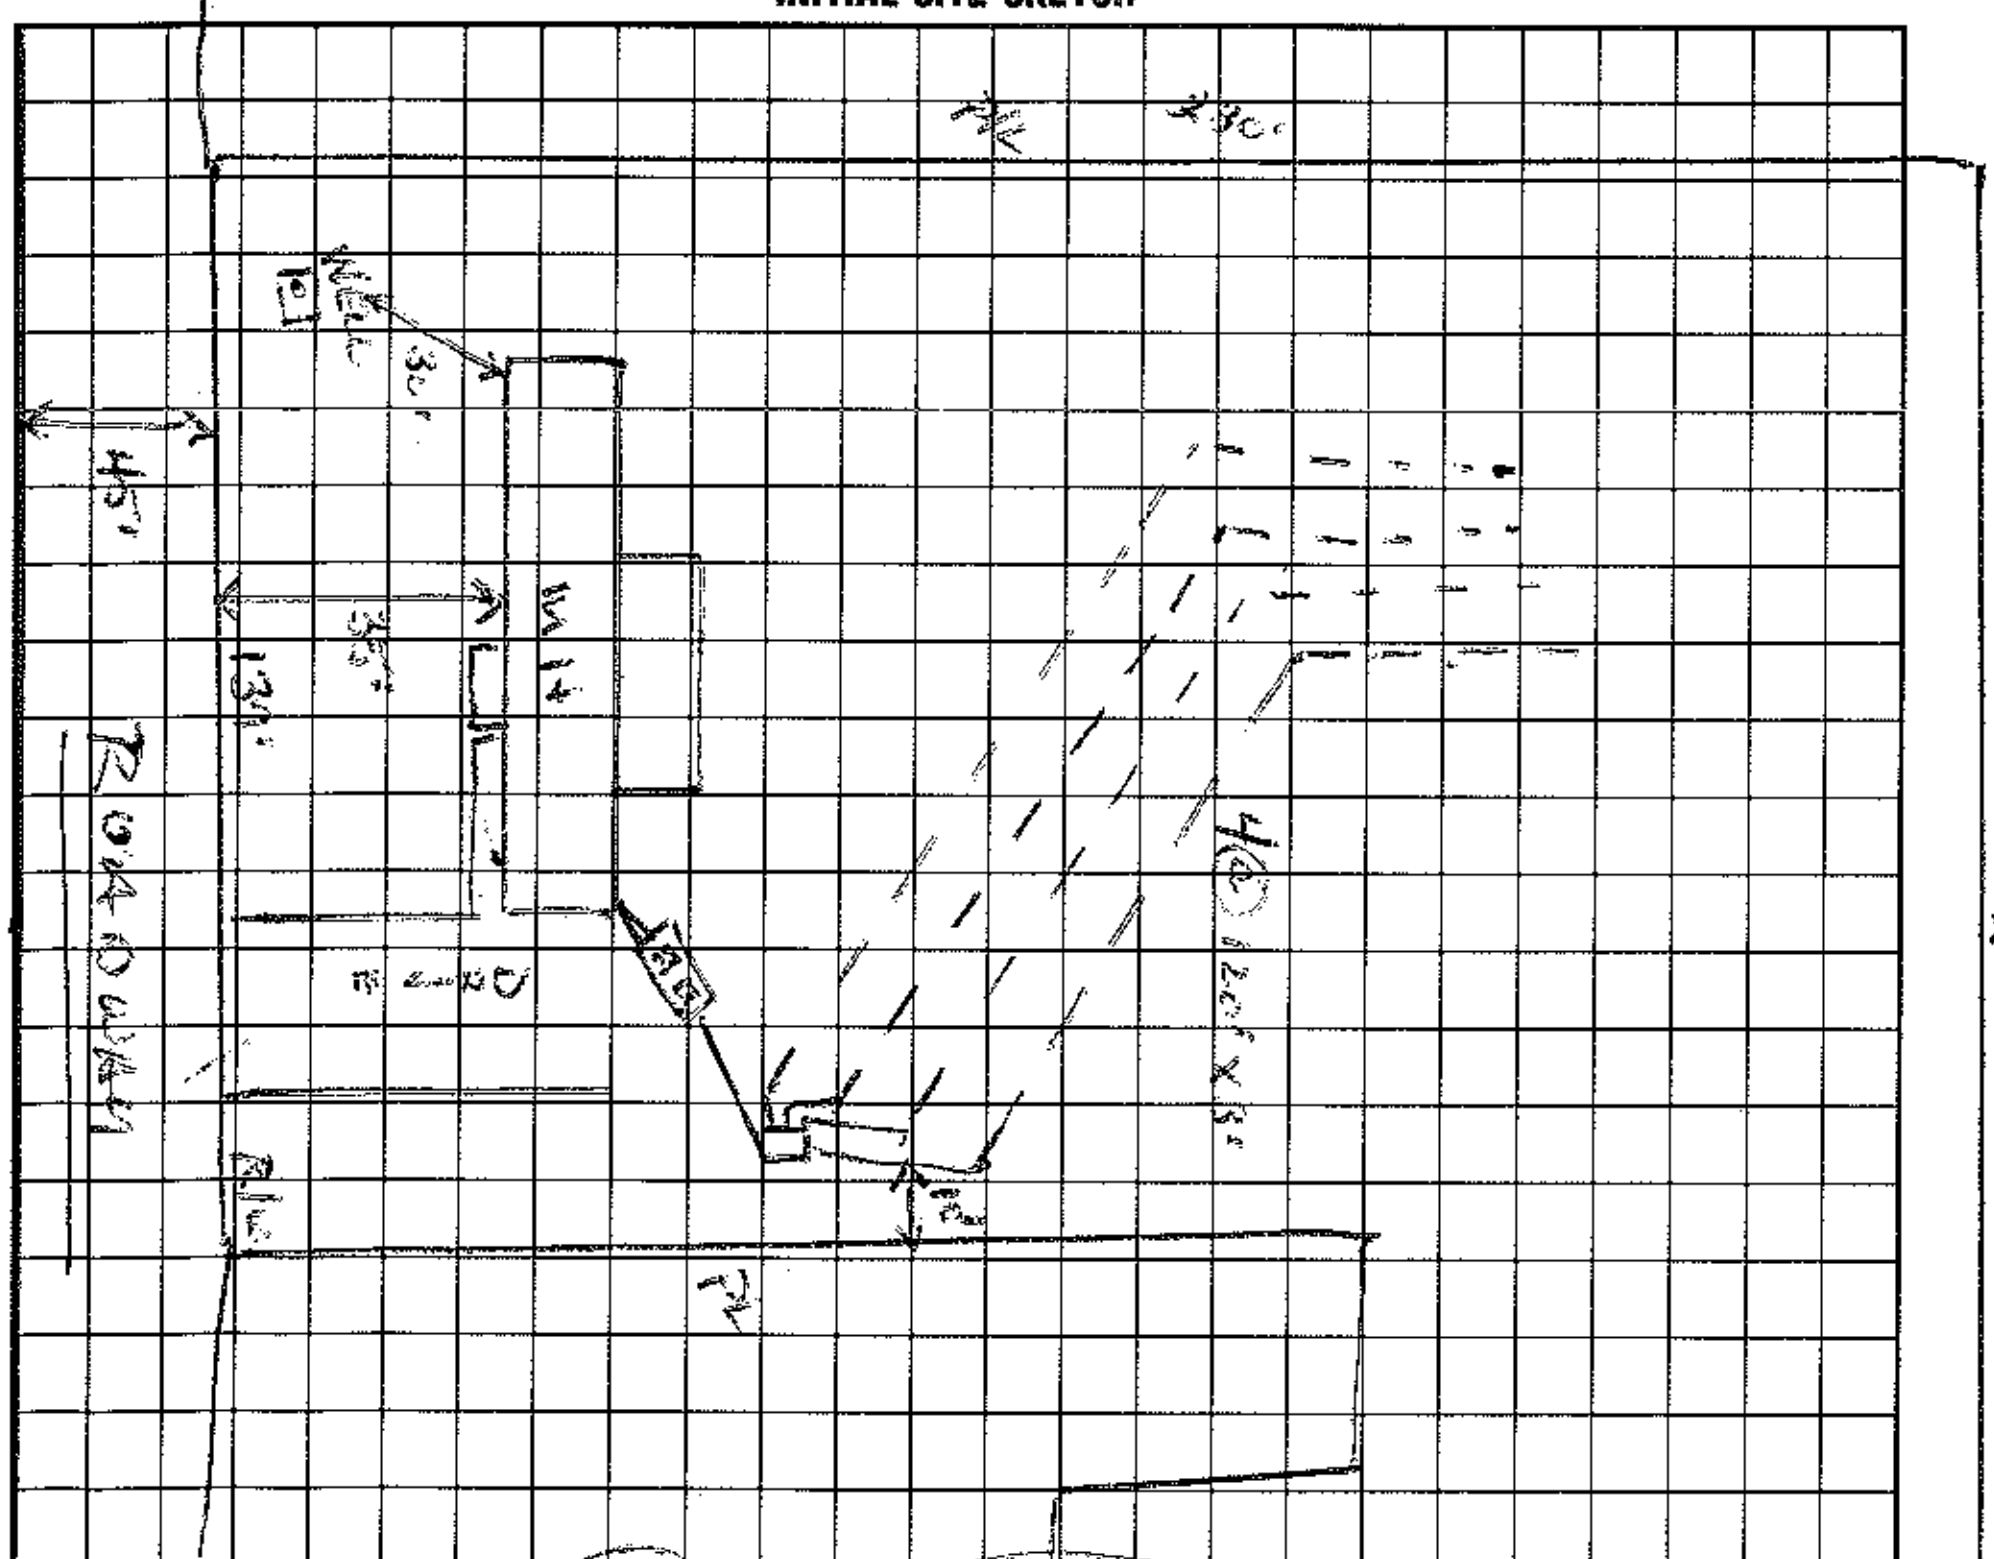

AS BUILT SKETCH

SAME AS INITIAL SKETCH

I understand that this permit can be suspended or revoked if any false information is supplied toward securing the permit/any unauthorized changes are made to the site/any unauthorized changes are made in the installation of the system.

Signed: X [signature] Installed by: G & M Enterprises

Improvement Permit by: Wesley Sparks RS date 12/19/95 Certificate of Completion by: ______ date ______

Authorization to Construct Existing System Inspection by: Wesley Sparks RS date 12/19/95 Operation Permit by: Brady Freeman / Michael J Dennis date 1-5-96

HEALTH DEPT. COPY: WHITE INSPECTION COPY (FINAL): GREEN OWNER COPY (FINAL): YELLOW INSPECTION COPY (INITIAL): PINK OWNER COPY (INITIAL): GOLD