# IREDELL COUNTY HEALTH DEPARTMENT

STATESVILLE 704-878-5305 MOORESVILLE 704-664-5281

## IMPROVEMENT PERMIT / CERTIFICATE OF COMPLETION / OPERATION PERMIT / EXISTING SYSTEM INSPECTION

PROPERTY DESCRIPTION NO. 22121 DATE 12/19/95 TAX MAP NO. 10 B 43 Watershed: ☐ Yes ☒ No

OWNER OR CONTRACTOR Jennifer Lynn Dixon PHONE: Business _____ Home 663-6163

ADDRESS 158 Hogan Ln. Mooresville, NC 28115

LOCATION 115-21N to Milo Ln. on (R) before curve of road 4659-50-3968 4659515238

SUBDIVISION MILOSAVLJEVIC BLOCK / SECTION 1 LOT 3 LOT AREA ~1 Ac SITE CLASS. PS DESIGN FLOW 360 L.T.A.R. .25

Septic Tank: 1000 Gallons; STB 821 Date 11-27-95
Pump Tank: — Gallons; PT — Date —
Pump Make: — Model — Serial No. —
Nitrification Field: No Fields 1 Square Feet 1440 Linear Feet 480
No Lines 4 Trench Width 36" Max Trench Bottom Depth 36" Gravel Depth 12"

☒ New System ☐ Repair System Type: I, II, III, IV, V, VI
System Description: CONVENTIONAL GRAVITY
Repair System Description: SAME
Maintenance Agreement Required: ☐ Yes ☒ No


☐ House/Mod. Home ☒ Mobile Home ☐ Business ☐ Other
No. Bedrooms 3 No. Bathrooms 2 No. Employees —
☐ Slab ☒ Crawl Space ☐ Basement w/plumbing ☐ Basement wo/plumbing

Water Supply: ☒ Individual ☐ Community ☐ Public

Comments:

Comments: Home and well not located at time of inspection. Keep both required distances from septic system.

### INITIAL SITE SKETCH

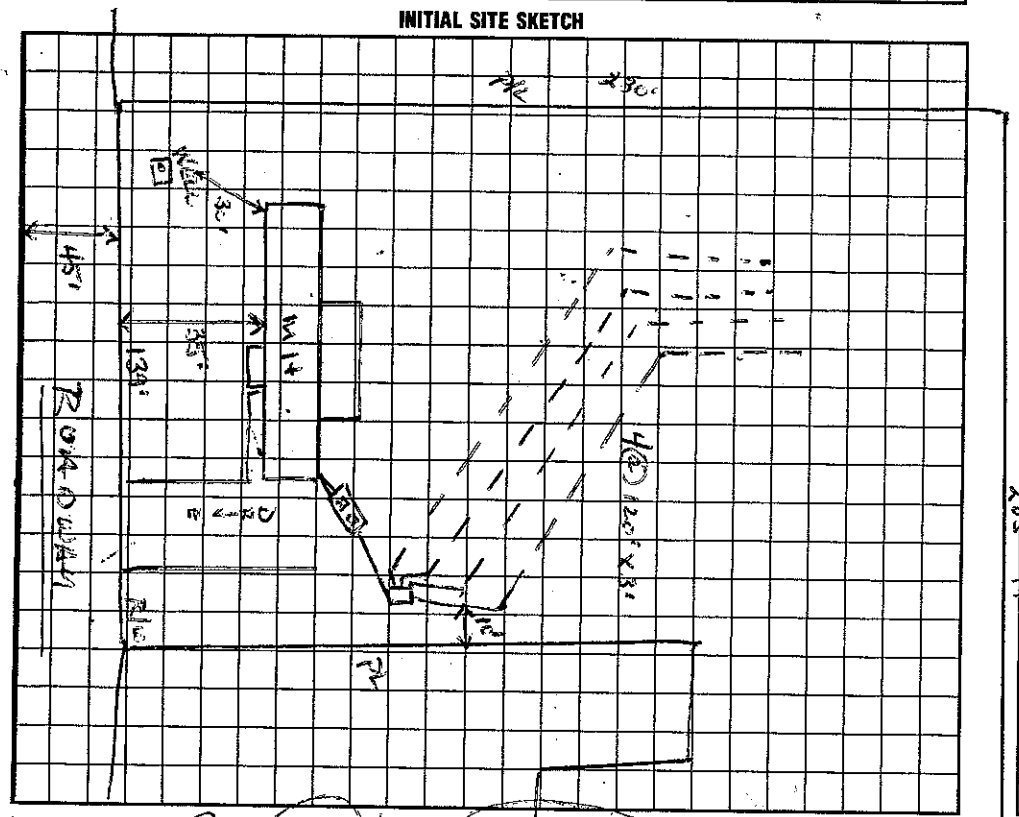


### AS BUILT SKETCH

SAME AS INITIAL SKETCH

I understand that this permit can be suspended or revoked if any false information is supplied toward securing the permit/any unauthorized changes are made to the site/any unauthorized changes are made in the installation of the system.

Signed: X

Improvement Permit by: Wesley Sparks RS date 12/19/95

Existing System Inspection by: Robert Wesley Sparks RS date 12/19/95

Installed by: G & M Enterprises

Certificate of Completion by: _____ date _____

Operation Permit by: Brady Freeman / Michael Dennis date 1-5-96

HEALTH DEPT. COPY: WHITE INSPECTION COPY (FINAL): GREEN OWNER COPY (FINAL): YELLOW INSPECTION COPY (INITIAL): PINK OWNER COPY (INITIAL): GOLD