IREDELL COUNTY HEALTH DEPARTMENT - *ENVIRONMENTAL HEALTH* ☐ STATESVILLE OFFICE 704-878-5305 ☐ MOORESVILLE OFFICE 704-664-5281

IMPROVEMENT PERMIT / AUTHORIZATION TO CONSTRUCT / OPERATION PERMIT / EXISTING SYSTEM INSPECTION

PERMIT # 170890 PIN # 4659515238 DATE 3-16-2012

OWNER Terry Allen Messer APPLICANT: Terry Allen Messer PHONE: Home/Cell # 704 224-5713 Business #

SITE ADDRESS 124 Milo Ln OWNER / APPLICANT ADDRESS 124 Milo Ln Mooresville, NC 28115

SITE DIRECTIONS Hwy 115/US 21 N. TR Milo Ln (just past Shepherd School) house is on right.

SUBDIVISION Milosavlevic BLOCK / SECTION LOT # 3 LOT AREA .74 Acre DESIGN FLOW 360gpd L.T.A.R. .25


Existing

Septic Tank 1000	Gallons: STB	Date	☐ New System ☐ Repair ☐ Expansion System Type I II III IV V VI	☒ Residence	No. Bedrooms 3	Water Supply
Pump Tank	Gallons: PT	Date	System Description: Existing System Gravity Conventional	☐ Business	No. Persons	☒ Private
Pump Make	Model	Serial #	Repair System Description: Modified Conventional	☐ Other	No. Employees	☐ Public
No. Nitrification Fields: 1	No. Lines 4	Linear Feet 480 ft	Maintenance Agreement Required ☐ YES ☒ NO	☐ Slab	☒ Crawl Space	☐ Community
Trench Width 36"	Max. Trench Bottom Depth 36"	Gravel Depth 12"	☒ GRAVITY ☐ PRESSURE	☐ Basement w/plumbing	☐ Basement w/o plumbing	

Comments / Conditions: Existing Septic System appears to be functioning Okay at time of inspection.

☆ Must keep new home at least 25ft to well. Footers for new home must be at least 5ft from Septic System.

INITIAL SITE SKETCH

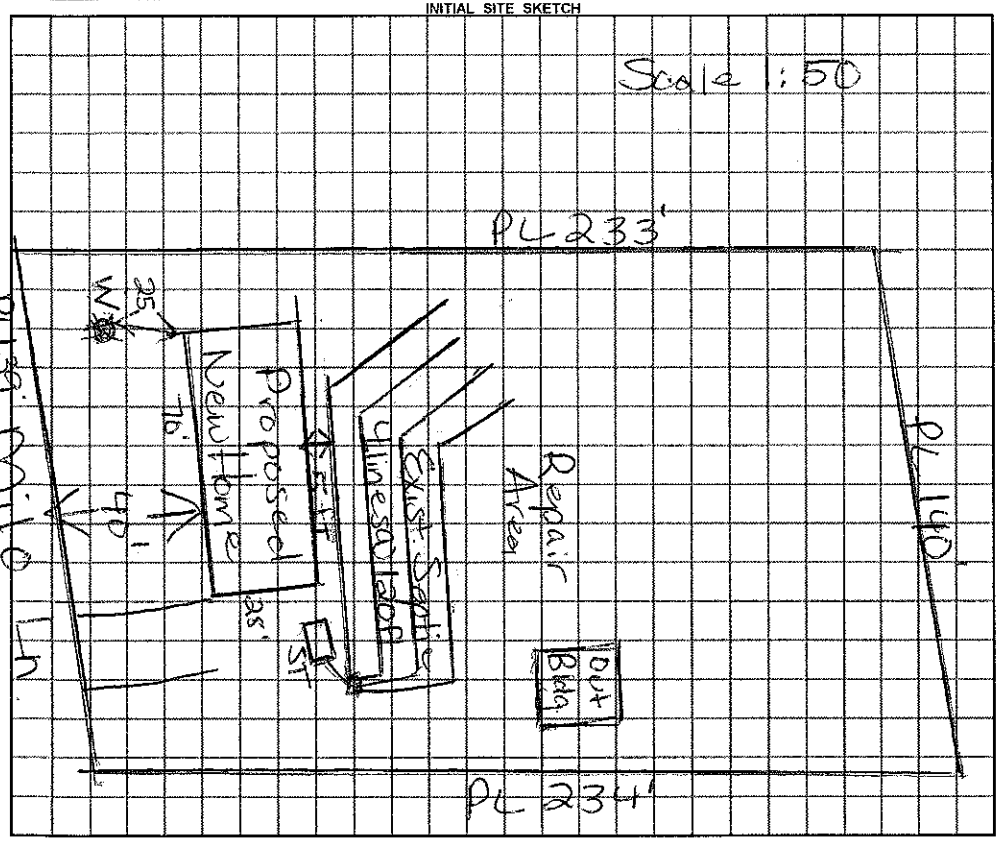

AS BUILT SKETCH

Permit can be suspended or revoked if any false information is supplied toward securing the permit / any unauthorized changes are made to the site / any unauthorized changes are made in the installation of the system.

☐ ***IMPROVEMENT PERMIT*** with plat valid without expiration. ☐ ***IMPROVEMENT PERMIT*** with plat valid without expiration. site plan valid 60 mo. ☐ ***AUTHORIZATION TO CONSTRUCT*** valid for period equal to IMPROVEMENT PERMIT--not to exceed 60 mo.

Owner / Applicant Signature: Terry A Messer Date 03-16-12 Installed by: G&M Enterprises on 1/5/96

IMPROVEMENT PERMIT by: ***REHS*** Date OPERATION PERMIT by: ***REHS*** Date

AUTHORIZATION TO CONSTRUCT by: ***REHS*** Date Existing System Inspected by: Maria H Peterson ***REHS*** Date 3/16/2012

YOU SHOULD CONTACT A LOCATOR SERVICE PRIOR TO ANY EXCAVATION

White Copy – Environmental Health YELLOW COPY (Final) Owner / Applicant PINK COPY (Initial) Owner / Applicant