IREDELL COUNTY HEALTH DEPARTMENT

STATESVILLE 704-878-5305 MOORESVILLE 704-664-5281

IMPROVEMENT PERMIT / AUTHORIZATION TO CONSTRUCT / OPERATION PERMIT / EXISTING SYSTEM INSPECTION

PERMIT# 075859 PIN# 4659 51 5491 DATE 8/25/98

OWNER OR CONTRACTOR BILLY HATFIELD PHONE: Business — Home —

ADDRESS #114 MILO LN MOORESVILLE NC 28115

LOCATION 2-1/115 - TL MILO LN PAST SHEPHARD SCHOOL - ON RT 4659-51-5491

SUBDIVISION MILO BLOCK / SECTION — LOT 4 LOT AREA .99AC SITE CLASS. PS DESIGN FLOW 360 L.T.A.R. 30 sq/ft

Septic Tank: 1000 Gallons; STB — Date —

Pump Tank: — Gallons; PT — Date —

Pump Make: — Model EXISTING Serial No. —

Nitrification Field: No Fields — Square Feet — Linear Feet —

No Lines — Trench Width — Max Trench Bottom Depth — Gravel Depth —

☐ New System ☐ Repair System Type: I, II, III, IV, V, VI

System Description: GRAVITY CONVENTIONAL

Repair System Description: —

Maintenance Agreement Required: ☐ Yes ☐ No

☑ House/Mod. Home No. Bedrooms 3

☐ Mobile Home No. Bathrooms 2

☐ Business No. Employees —

☐ Other —

☐ Slab ☐ Crawl Space ☐ Basement w/plumbing ☐ Basement wo/plumbing

Water Supply: ☑ Individual ☐ Public ☑ Community


Comments:/Conditions:

Comments:/Conditions:

EXISTING

INITIAL SITE SKETCH

AS BUILT SKETCH

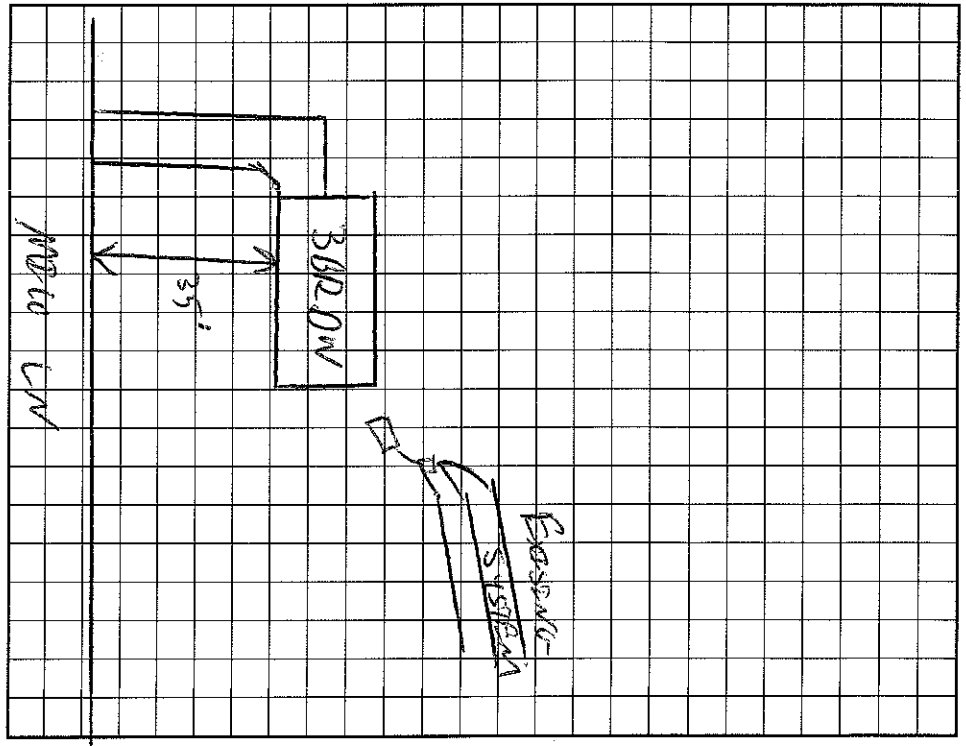

I understand that this permit can be suspended or revoked if any false information is supplied toward securing the permit/any unauthorized changes are made to the site/any unauthorized changes are made in the installation of the system Improvement Permit with plat valid without expiration. Improvement Permit with site plan valid for sixty months. Authorization to Construct is valid for a period equal to that of Improvement Permit – not to exceed sixty months.

Signed: _____ date 8-26-98 Installed by: _____

Improvement Permit by: _____ date _____ Operation Permit by: _____ date _____

Authorization to Construct by: _____ date _____ Existing System Inspection by: _____ date 8/25/98

HEALTH DEPT. COPY: WHITE INSPECTION COPY (FINAL): GREEN OWNER COPY (FINAL): YELLOW INSPECTION COPY (INITIAL): PINK OWNER COPY (INITIAL): GOLD