IREDELL COUNTY HEALTH DEPARTMENT

AUTHORIZATION TO CONSTRUCT

STATESVILLE 704-878-5305 MOORESVILLE 704-664-5281

IMPROVEMENT PERMIT / ~~CERTIFICATE OF COMPLETION~~ / OPERATION PERMIT / EXISTING SYSTEM INSPECTION

PROPERTY DESCRIPTION NO. 25051 DATE 10/2/96 TAX MAP NO. 1Q -B-43 pt of Watershed: ☑ Yes ☐ No

OWNER OR CONTRACTOR JENNIFER KENDRICK PHONE: Business 4659-51-5491 Home 896-4785

ADDRESS BOX 964 MOORESVILLE

LOCATION 21/1175 TL MILO LN ON RT

SUBDIVISION PETER MILO SUBDIV BLOCK / SECTION LOT 4 LOT AREA 1.164C SITE CLASS. PS DESIGN FLOW 360GPD L.T.A.R. .36 PD/FT²

Septic Tank: 1000 Gallons; STB 794 Date 7/5/96

Pump Tank: Gallons; PT Date

Pump Make: Model Serial No.

Nitrification Field: No Fields 1 Square Feet 1200 Linear Feet 400

No Lines 5 Trench Width 36" Max Trench Bottom Depth 36" Gravel Depth 12"

☑ New System ☐ Repair System Type: I (II) III, IV, V, VI

System Description: GRAVITY CONVENTIONAL

Repair System Description: PUMP/GRAVITY CHAMBERED

Maintenance Agreement Required: ☐ Yes ☑ No

☐ House/Mod. Home ☑ Mobile Home ☐ Business ☐ Other

No. Bedrooms 3 No. Bathrooms 2 No. Employees


Water Supply: ☑ Individual ☐ Community ☐ Public

☐ Slab ☑ Crawl Space ☐ Basement w/plumbing ☐ Basement wo/plumbing


Comments:

Comments:

INITIAL SITE SKETCH 1"=60'

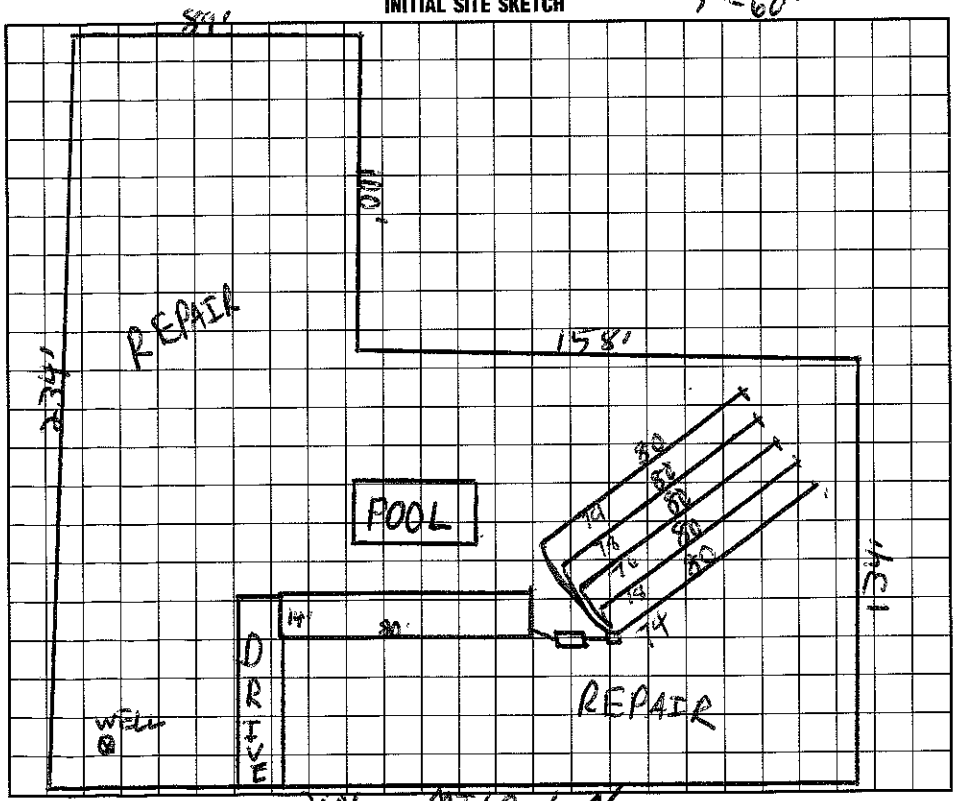

AS BUILT SKETCH

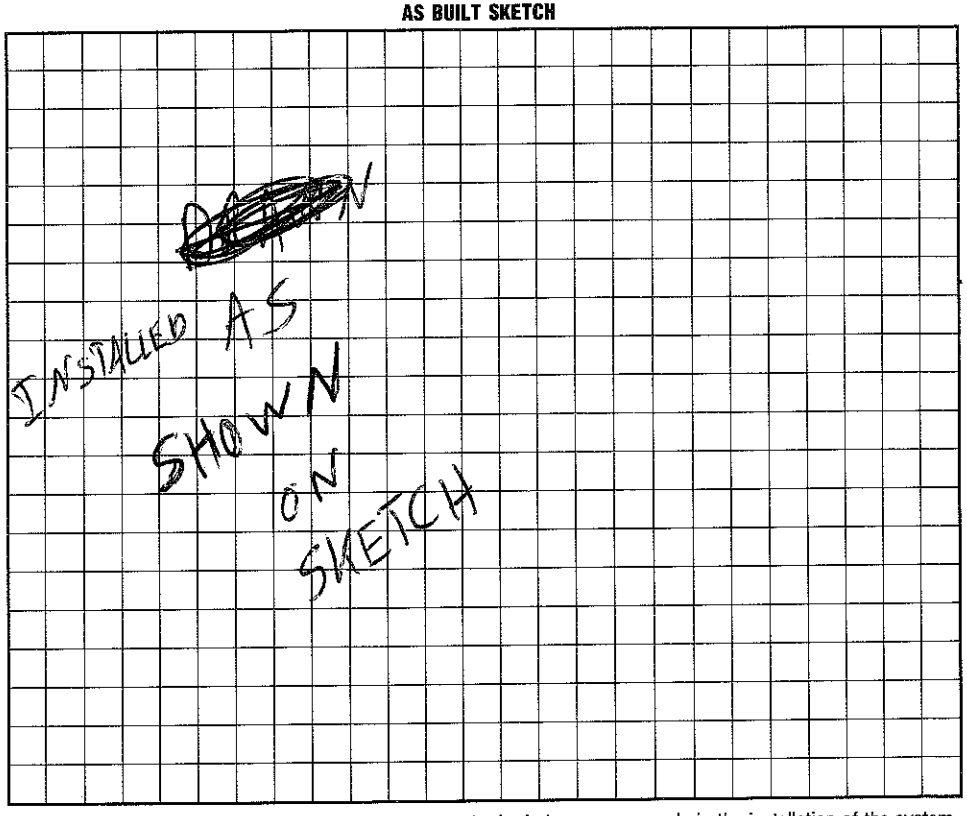

I understand that this permit can be suspended or revoked if any false information is supplied toward securing the permit/any unauthorized changes are made to the site/any unauthorized changes are made in the installation of the system.

Signed: Billy S Hatfield

Installed by: A-1 BACKHOE

Improvement Permit by: C. Riley Fenn EHSI date 10/2/96

Certificate of Completion by: date

Existing System Inspection by: AUTHORIZATION TO CONSTRUCT C. Riley Fenn EHSI date 10/2/96

Operation Permit by: C. Riley Fenn EHSI date 11/7/96

HEALTH DEPT. COPY: WHITE INSPECTION COPY (FINAL): GREEN OWNER COPY (FINAL): YELLOW INSPECTION COPY (INITIAL): PINK OWNER COPY (INITIAL): GOLD