IREDELL COUNTY HEALTH DEPARTMENT

Authorization to Construct

STATESVILLE 704-878-5305 MOORESVILLE 704-664-5281

IMPROVEMENT PERMIT / ~~CERTIFICATE OF COMPLETION~~ / OPERATION PERMIT / EXISTING SYSTEM INSPECTION

PROPERTY DESCRIPTION NO. 069853 DATE 10/7/97 TAX MAP NO. 4659 51 7656 Watershed: ☒ Yes ☐ No

OWNER OR CONTRACTOR Thomas Lowing PHONE: Business Home 664-9129

ADDRESS 201 Blackberry Lane Mooresville, NC. 28115 4659-51-7656

LOCATION 115 N TL Milo Lane to first lot on ®

SUBDIVISION MILOSAVLJEVIC BLOCK / SECTION LOT 5 LOT AREA ~1.00 Ac SITE CLASS. PS DESIGN FLOW 360 L.T.A.R. .3

Septic Tank: 1000 Gallons; STB Date

Pump Tank: Gallons; PT Date

Pump Make: Model Serial No.

Nitrification Field: No Fields 1 Square Feet 1200 Linear Feet 400

No Lines 3 Trench Width 36" Max Trench Bottom Depth 30" Gravel Depth 12"

☒ New System ☐ Repair System Type: I, ☐ II, III, IV, V, VI

System Description: DIST BOX — CONVENTIONAL

Repair System Description: CONV.

Maintenance Agreement Required: ☐ Yes ☒ No

☐ House/Mod. Home No. Bedrooms 3

☒ Mobile Home No. Bathrooms 3

☐ Business No. Employees

☐ Other


☐ Slab ☒ Crawl Space ☐ Basement w/plumbing ☐ Basement wo/plumbing

Water Supply: ☒ Individual ☐ Community ☐ Public


Comments:

Comments: Well location must be moved to the right of driveway due to Septic Tank System

INITIAL SITE SKETCH

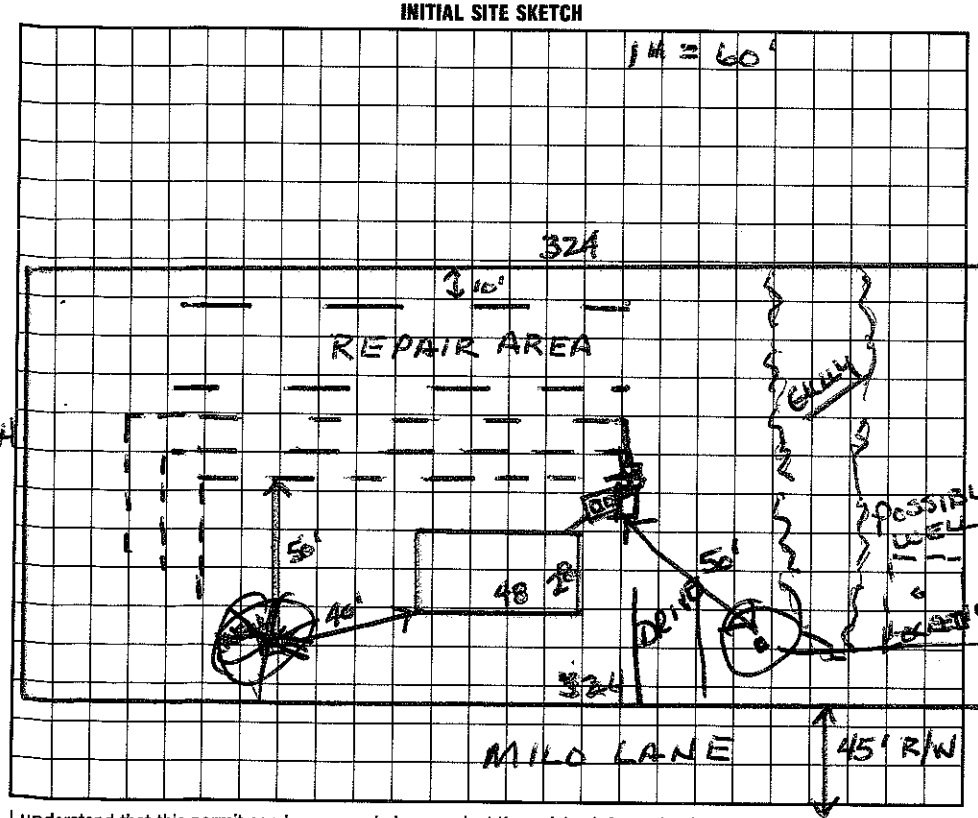

AS BUILT SKETCH

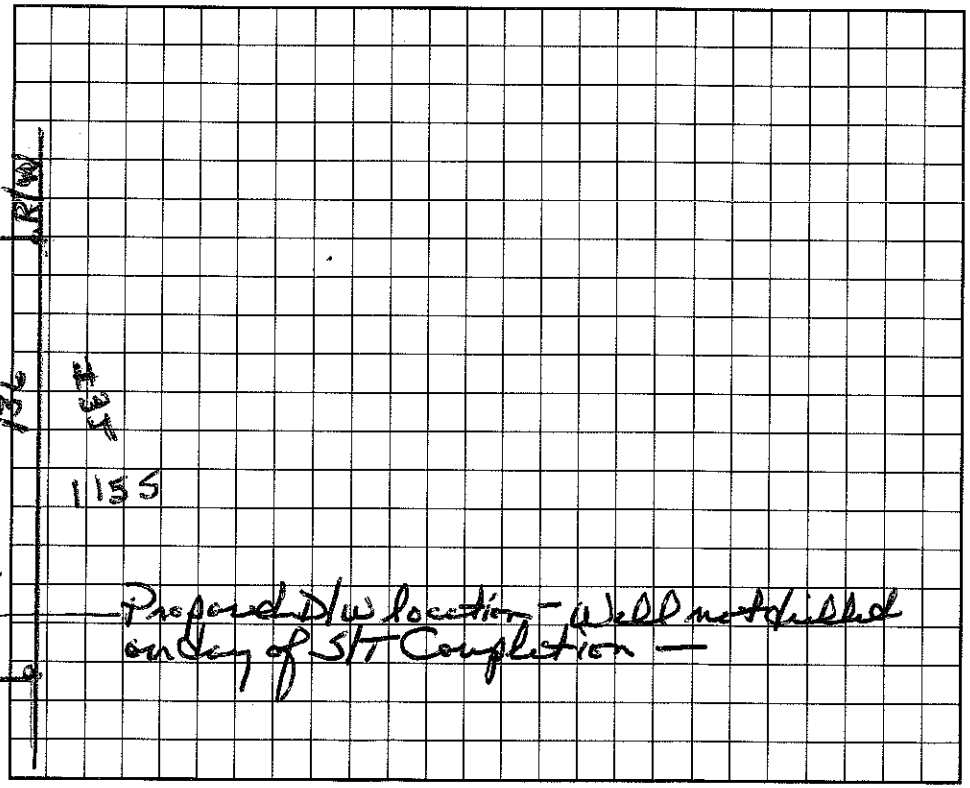

I understand that this permit can be suspended or revoked if any false information is supplied toward securing the permit/any unauthorized changes are made to the site/any unauthorized changes are made in the installation of the system. Improvement Permit is valid for 60 months from date of issuance.

Signed: * Thomas R Lowing 1-16-98

Improvement Permit by: Wesley Sparks R.S. date 10/7/97

~~Existing System Inspection~~ by: Wesley Sparks R.S. date 10/7/97

Installed by: A-1 Backhoe

Certificate of Completion by: Wesley Sparks R.S. date 2/2/98

Operation Permit by: Wesley Sparks R.S. date 2/2/98

HEALTH DEPT. COPY: WHITE INSPECTION COPY (FINAL): GREEN OWNER COPY (FINAL): YELLOW INSPECTION COPY (INITIAL): PINK OWNER COPY (INITIAL): GOLD