IREDELL COUNTY HEALTH DEPARTMENT

STATESVILLE 704-878-5305 550, Paid MOORESVILLE 704-664-5281

IMPROVEMENT PERMIT / AUTHORIZATION TO CONSTRUCT / OPERATION PERMIT / EXISTING SYSTEM INSPECTION

PERMIT# 131889 PIN# 4659610337 DATE 11-28-05

OWNER OR APPLICANT Larry McLean PHONE: Business 704-663-1660 Home same

ADDRESS 1736 Charlotte Hwy Mooresville 28115

LOCATION Hwy 21 N, on left past shepherd school

SUBDIVISION _____ BLOCK / SECTION _____ LOT _____ LOT AREA 1.587Ac SITE CLASS. PS DESIGN FLOW 360gpd L.T.A.R. .3 gpd/ft²

Septic Tank: 1000 Gallons; STB 794 Date 7-12-05
Pump Tank: 1000 Gallons; PT 283 Date 2-24-06
Pump Make: Zoeller Model 4HP153 Serial No. _____
Nitrification Field: No Fields 1 Square Feet 1200 Linear Feet 300
No Lines 4 Trench Width 36" Max Trench Bottom Depth 36" Gravel Depth NA ☐ Gravity ☒ Pressure

☒ New System ☐ Repair ☐ Expansion System Type: I II (III) IV V VI
System Description: 25% reduction, pm
Repair System Description: Same
Maintenance Agreement Required: ☐ Yes ☒ No

☒ House/Mod. Home ☐ Mobile Home ☐ Business ☐ Other
No. Bedrooms 3 No. Persons ____ No. Employees ____

Water Supply: ☒ Individual ☐ Public ☐ Community


☐ Slab ☒ Crawl Space ☐ Basement w/plumbing ☐ Basement wo/plumbing

Comments/Conditions: Deck posts to be 5' at least from supply line-from PT to PM
Hold AC until receive recorded deed

Comments/Conditions: 4/25/06 Checked tanks, lines & Pressure
Checked Elect & alarm 6/18/14


1" = 60'

INITIAL SITE SKETCH

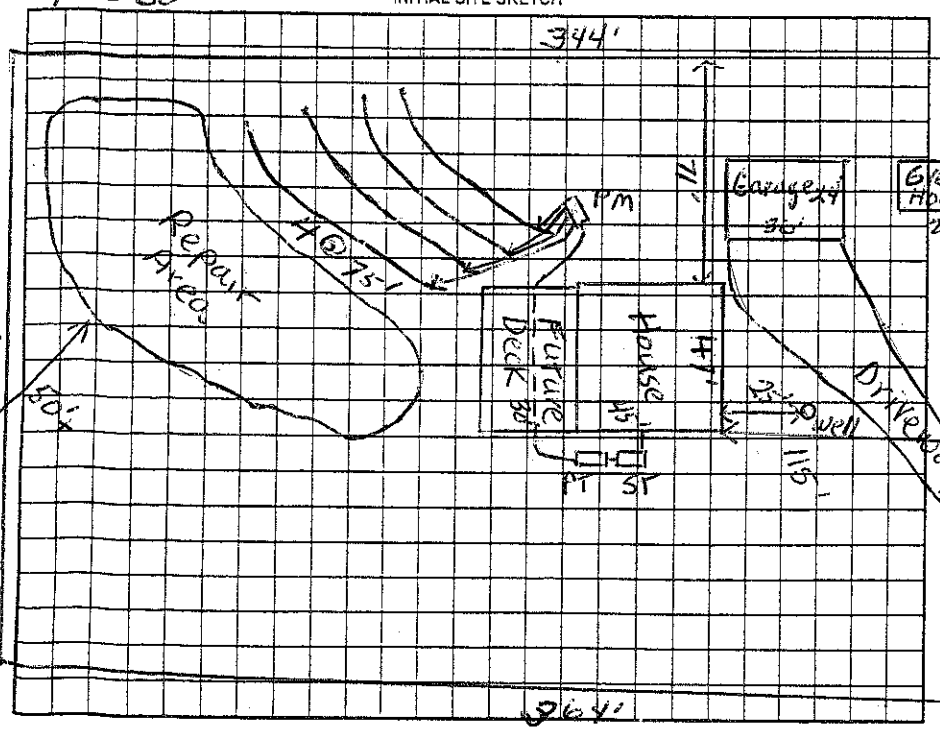

AS BUILT SKETCH

Used ET Flow

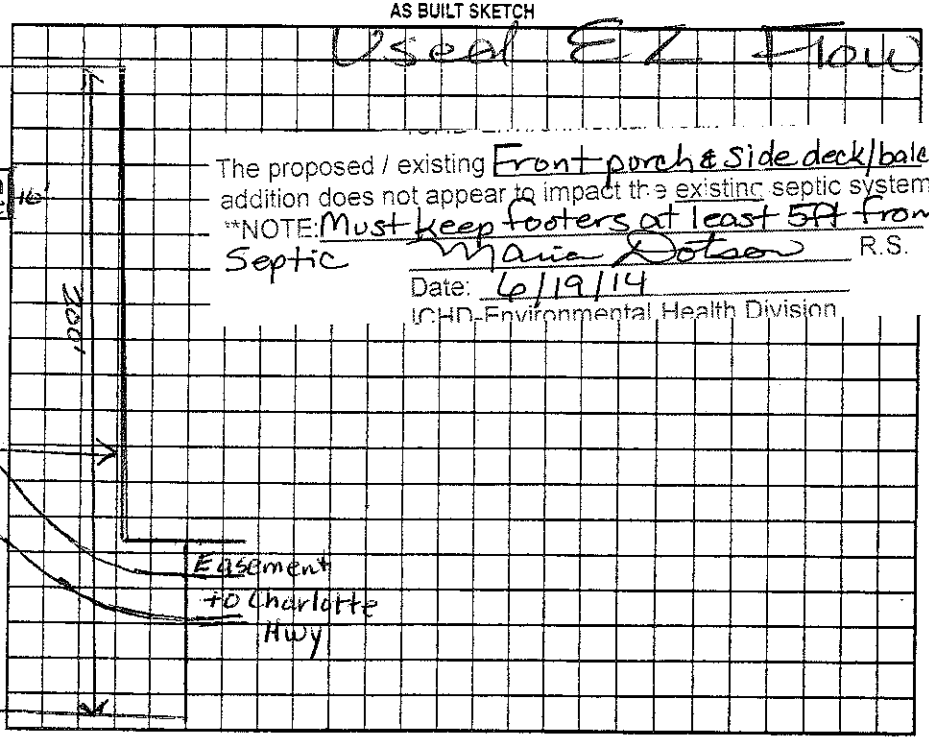

The proposed / existing Front porch & Side deck/balcony addition does not appear to impact the existing septic system.
**NOTE: Must keep footers at least 5ft from Septic

Maria Dotson R.S.
Date: 6/19/14
ICHD-Environmental Health Division

Permit can be suspended or revoked if any false information is supplied toward securing the permit/any unauthorized changes are made to the site/any unauthorized changes are made in the installation of the system. Improvement Permit with plat valid without expiration ☐ Improvement Permit with site plan valid for sixty months ☒ Authorization to Construct is valid for a period equal to that of Improvement Permit – not to exceed sixty months.

Signed: Larry McLean date 3-16-06 Installed by: Willie Johnston Bus
Improvement Permit by: Judy Melville date 11-28-05 Operation Permit by: Maria Dotson date 6/18/14
Authorization to Construct by: Judy Melville date 3-23-06 Existing System Inspection by: _____ date _____

HEALTH DEPT. COPY: WHITE OWNER COPY (FINAL): YELLOW OWNER COPY (INITIAL): PINK