IREDELL COUNTY HEALTH DEPARTMENT

Statesville Office (704) 878-5305 Mooresville Office (704) 660-3625 PERMIT # 208579

IMPROVEMENT PERMIT / AUTHORIZATION TO CONSTRUCT / OPERATION PERMIT / EXISTING SYSTEM

PIN # 4659-52-5794

APPLICANT: PHILLIP MORGART APPLICANT ADDRESS: 2445 CHARLOTTE HWY

SITE ADDRESS: 182 DIDIO CIR. PHONE: 704-252-4671 ALT. PHONE:

SITE DIRECTIONS: 21N, TR DIDIO CIR.

SUBDIVISION: SECTION: LOT # LOT AREA: 1.06 AC DESIGN FLOW: 360 L.T.A.R.: .225 (.3R)

Septic Tank 1000 (gal) STB 1060 Date 2D FILTRATE
Pump Tank (gal) PT Date
Pump Make Model Serial #
Nitrification Fields 1 # Lines 5 Linear Ft: 400'
Trench Width 36" Max. Trench Bottom Depth X 14" X Gravel Depth —


☒ New System ☐ Repair ☐ Expansion System Type: I II (III) IV V VI
System Description: 25% REDUCTION
Repair System Description: LP - PANEL BLOCK
Maintenance Agreement Required: ☐ YES ☒ NO
☒ GRAVITY ☐ PRESSURE

☒ Residence No. Bedrooms 3
☐ Business No. Persons
☐ Other No. Employees
☐ Slab ☐ Crawl Space
☒ Basement w/plumbing ☐ Basement w/o plumbing


Water Supply: ☒ Private ☐ Public ☐ Community

Comments / Conditions: X TRENCH MUST BE NO DEEPER THAN 14". MINIMUM 4" COVER TO BE BROUGHT IN FOR A TOTAL OF 6". X

INITIAL SITE SKETCH

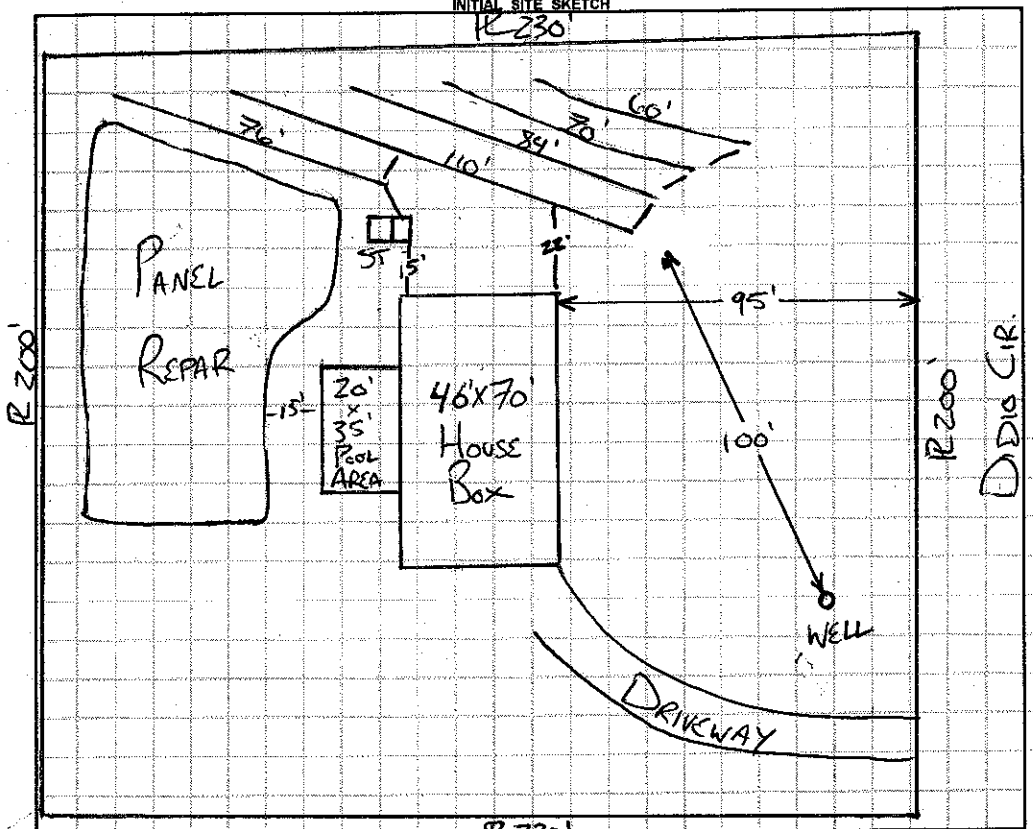

AS BUILT SKETCH

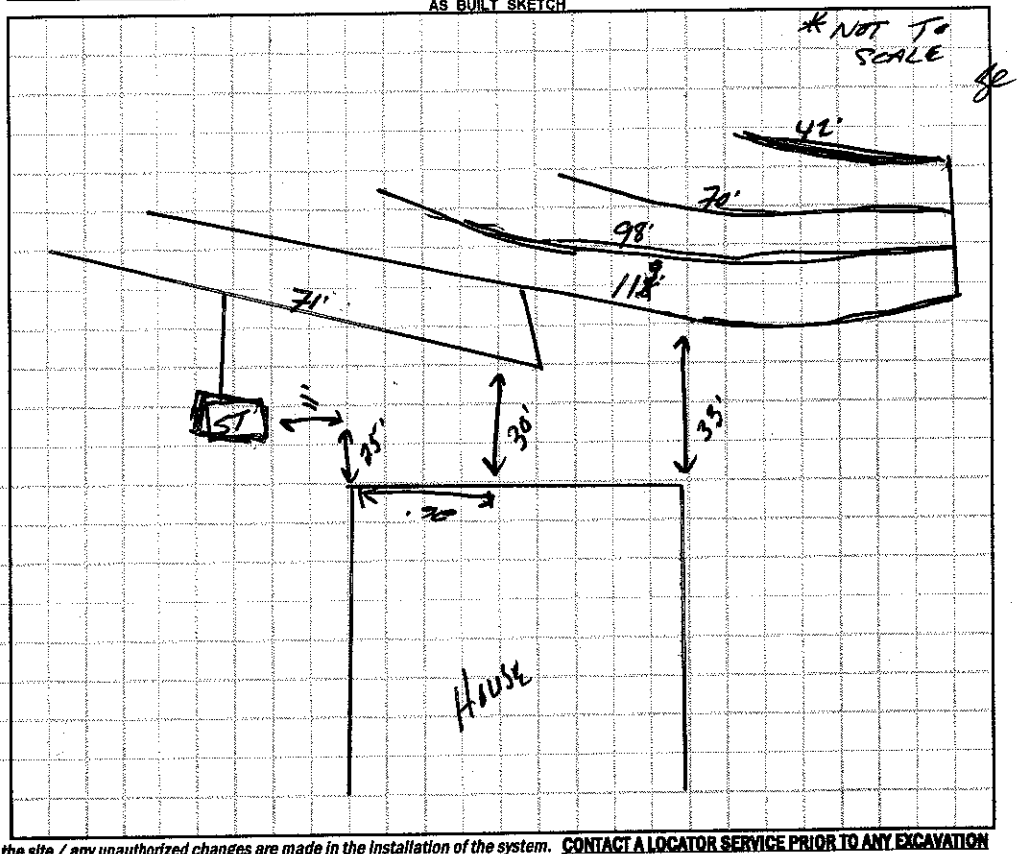

Permit can be suspended or revoked if any false information is supplied toward securing the permit / any unauthorized changes are made to the site / any unauthorized changes are made in the installation of the system. **CONTACT A LOCATOR SERVICE PRIOR TO ANY EXCAVATION**

☐ **IMPROVEMENT PERMIT** *with plat valid without expiration.* ☒ **IMPROVEMENT PERMIT** *with site plan valid for 60 mos.* ☒ **AUTHORIZATION TO CONSTRUCT** *valid for period equal to IMPROVEMENT PERMIT--not to exceed 60 mo.*

Owner / Applicant Signature: Date: 6/4/15 Installed by:

IMPROVEMENT PERMIT by: APPROVED APR 01 2015 OPERATION PERMIT by: APPROVED AUG 04 2015

AUTHORIZATION TO CONSTRUCT by: APPROVED JUN 05 2015 Existing System Inspected by: Date:

Health Dept. Copy - WHITE Applicant (Final Approval) - YELLOW Applicant (Conditional Approval) - PINK