IREDELL COUNTY HEALTH DEPARTMENT

Statesville Office (704) 878-5305 Mooresville Office (704) 660-3625 PERMIT # 209255

IMPROVEMENT PERMIT / AUTHORIZATION TO CONSTRUCT / OPERATION PERMIT / EXISTING SYSTEM

PIN # 4659-54-4911

APPLICANT: ERIC WARD APPLICANT ADDRESS: 1124 CHARLOTTE HWY TROUTMAN

SITE ADDRESS: 208 FREEZE CROSSING DR. PHONE: 704-883-6148 ALT. PHONE:

SITE DIRECTIONS: 21N, TR FREEZE CROSSING C END ON R


SUBDIVISION: FREEZE CROSSING SECTION: LOT # 17 LOT AREA: 1.14 AC DESIGN FLOW: 480 L.T.A.R.: .3

Septic Tank	1000	(gal)	STB	1012	Date	3-14-15	☒ New System	☐ Repair	☐ Expansion	System Type: I II (III) IV V VI	
Pump Tank		(gal)	PT		Date		System Description:	25% REDUCTION			
Pump Make			Model		Serial #		Repair System Description:	25% REDUCTION			
# Nitrification Fields	1		# Lines	5	Linear Ft:	400'	Maintenance Agreement Required:	☐ YES	☒ NO		
Trench Width	36"		Max. Trench Bottom Depth	32"	Gravel Depth	—	☒ GRAVITY	☐ PRESSURE			


☒ Residence	No. Bedrooms	4	Water Supply	
☐ Business	No. Persons		☒ Private	
☐ Other	No. Employees		☐ Public	
☐ Slab	☒ Crawl Space		☐ Community	
☐ Basement w/plumbing			☐ Basement w/o plumbing	

Comments / Conditions:

INITIAL SITE SKETCH

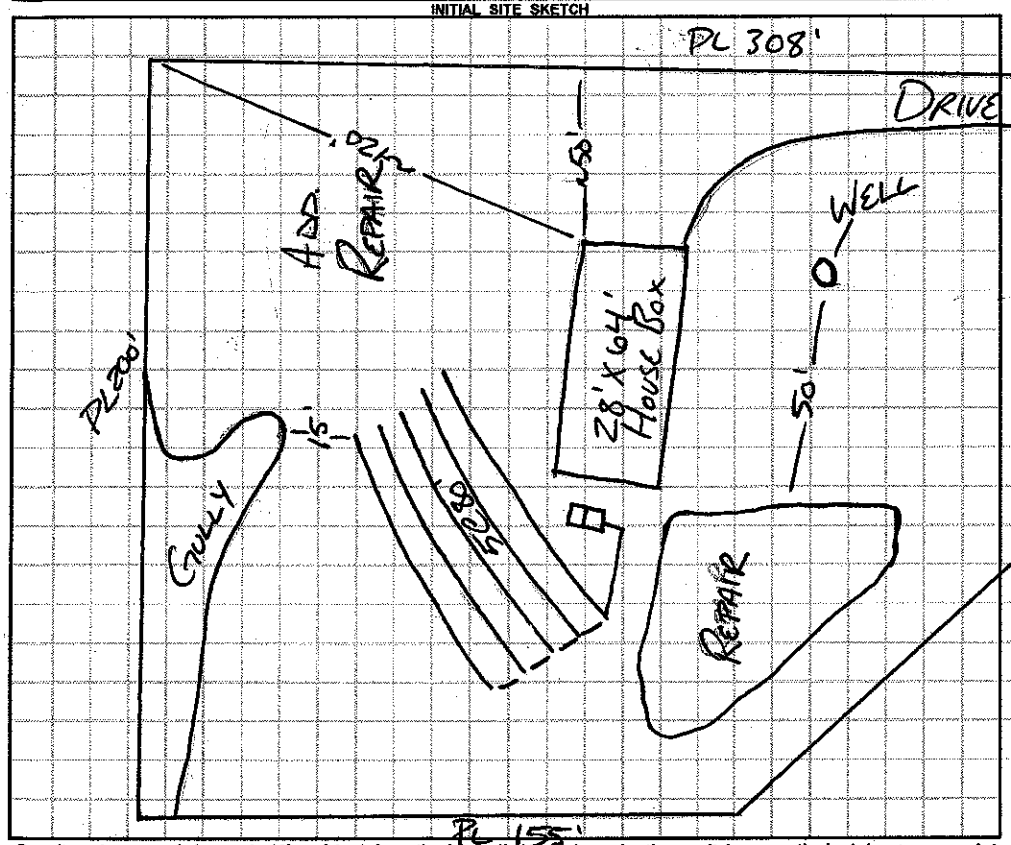

AS BUILT SKETCH

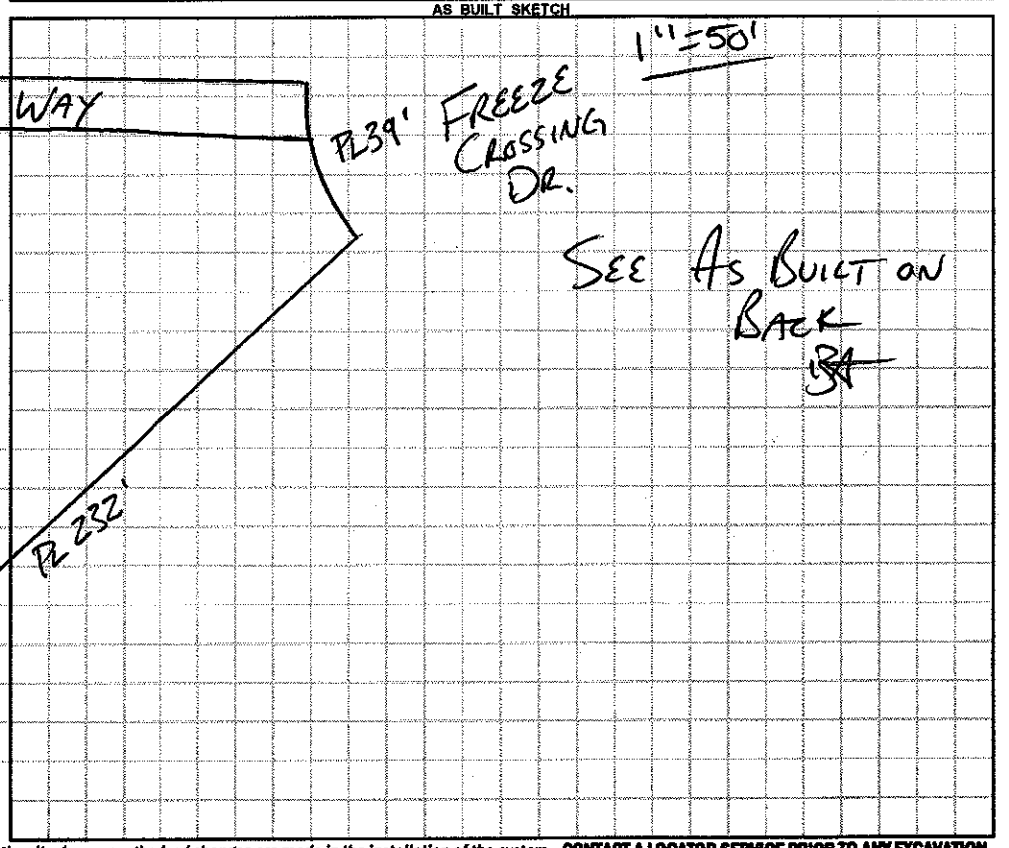

Permit can be suspended or revoked if any false information is supplied toward securing the permit / any unauthorized changes are made to the site / any unauthorized changes are made in the installation of the system. **CONTACT A LOCATOR SERVICE PRIOR TO ANY EXCAVATION**

☐ **IMPROVEMENT PERMIT** *with plat valid without expiration.* ☐ **IMPROVEMENT PERMIT** *with site plan valid for 60 mos.* ☒ **AUTHORIZATION TO CONSTRUCT** *valid for period equal to IMPROVEMENT PERMIT--not to exceed 60 mo.*

Owner / Applicant Signature: Eric Ward Date: 4-23-15 Installed by: CRAIG THOMPSON

IMPROVEMENT PERMIT by: APPROVED Date: APR 22 2015 OPERATION PERMIT by: APPROVED Date: JUL 09 2015

AUTHORIZATION TO CONSTRUCT by: APPROVED Date: APR 22 2015 Existing System Inspected by: Date:

Health Dept. Copy - WHITE Applicant (Final Approval) - YELLOW Applicant (Conditional Approval) - PINK