4659-55-0204

IREDELL COUNTY HEALTH DEPARTMENT

STATESVILLE 704-878-5305 MOORESVILLE 704-664-5281

IMPROVEMENT PERMIT / CERTIFICATE OF COMPLETION / OPERATION PERMIT / EXISTING SYSTEM INSPECTION

PROPERTY DESCRIPTION NO. 16721 DATE 9/8/93 TAX MAP NO. 4E 4A 13

OWNER OR CONTRACTOR ROBERT CYORK PHONE: Business 664-6538 Home

ADDRESS 900 W WILSON AVE MOORESVILLE, NC.

LOCATION LOT 13 FREEZE CROSSING

SUBDIVISION FREEZE CROSSING BLOCK / SECTION LOT 13 LOT AREA ~2.9AC SITE CLASS. P L.T.A. 25.3

Water Supply: ☑ Individual ☐ Community ☐ Public

Septic Tank: 1000 Gallons; STB 358 Date 6-19-93

Pump Tank: Gallons; PT Date

Nitrification Field: No Fields 1 Square Feet 1200 Linear Feet 400

No Lines 4 Trench Width 3' Trench Depth 36" Gravel Depth 12"

☑ New System ☐ Repair System Type: I (II) III, IV, V, VI

System Description: CONV

Repair System Description: CONV

Maintenance Agreement Required: ☐ Yes ☑ No

☑ House/Mod. Home No. Bedrooms 3 Garbage Disposal: ☐ Yes ☑ No

☐ Mobile Home No. Bathrooms 2 Auto. Dishwasher: ☑ Yes ☐ No


☐ Business No. Employees Auto. Washing Machine: ☑ Yes ☐ No

☐ Other Other

☐ Slab ☑ Crawl Space ☐ Basement w/plumbing ☐ Basement wo/plumbing

Comments TRENCH DEPTH NO GREATER THAN 36"
System may be installed in repair area and area shown for expansion front used for repair area. Keep tank shallow no more than 10" above required.

INITIAL SITE SKETCH

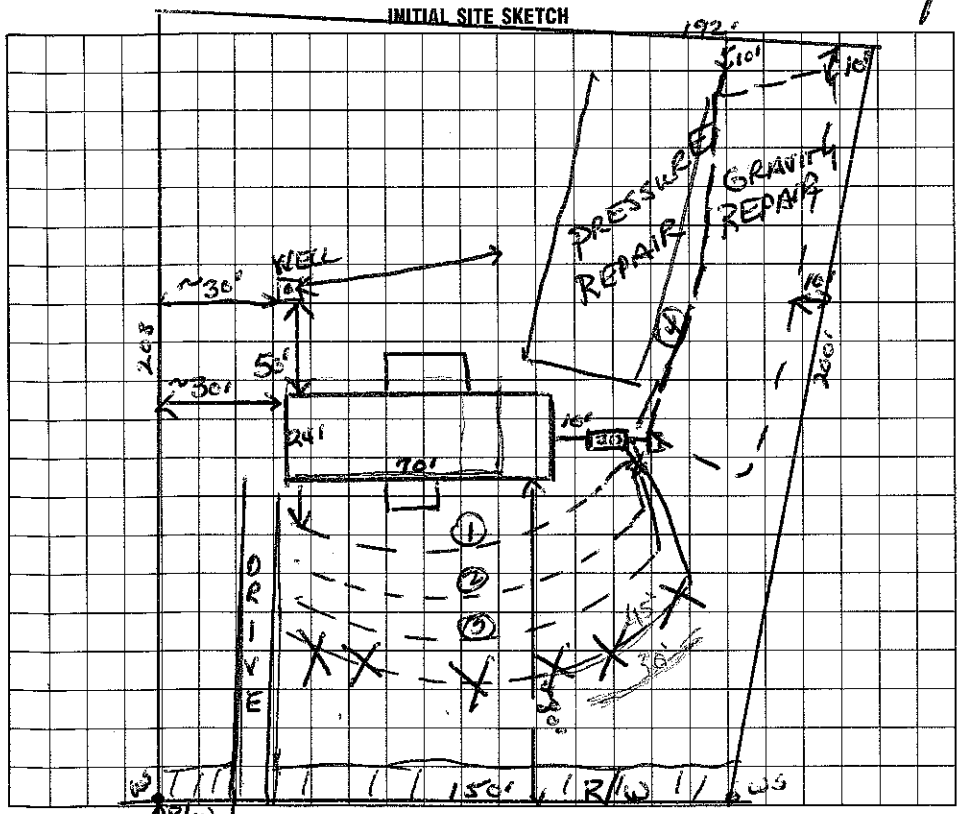

AS BUILT SKETCH

Installed as shown on Imp. Permit

I understand that this permit can be suspended or revoked if any false information is supplied toward securing the permit/any unauthorized changes are made to the site/any unauthorized changes are made in the installation of the system. Improvement Permit is valid for 60 months from date of issuance.

Signed: Robert C York

Improvement Permit by: Wesley Sparks R.S. date 9/8/93

Existing System Inspection by: date

Installed by: Foster Pool & Construction Co.

Certificate of Completion by: Wesley Sparks R.S. date 9/24/93

Operation Permit by: date

HEALTH DEPT. COPY: WHITE INSPECTION COPY (FINAL): GREEN OWNER COPY (FINAL): YELLOW INSPECTION COPY (INITIAL): PINK OWNER COPY (INITIAL): GOLD