4659-55-1276

IREDELL COUNTY HEALTH DEPARTMENT

STATESVILLE 704-878-5305 MOORESVILLE 704-664-5281

IMPROVEMENT PERMIT / CERTIFICATE OF COMPLETION / OPERATION PERMIT / EXISTING SYSTEM INSPECTION

PROPERTY DESCRIPTION NO. 17089 DATE 9/30/93 TAX MAP NO. 4E 4A 14

OWNER OR CONTRACTOR ELMER HORTON PHONE: Business Home 664-6259

ADDRESS Rt 9 BOX 281 MOORESVILLE, NC.

LOCATION ~~AUSTIN CHEEK~~, ON (L) JUST BEFORE CUL DE SAC

SUBDIVISION FREEZE CROSSING BLOCK / SECTION LOT 14 LOT AREA ~ 29000FT² SITE CLASS. P L.T.A.R. .35-.3

Water Supply: ☑ Individual ☐ Community ☐ Public (PROPOSED)

Septic Tank: 1000 Gallons; STB 358 Date 9-8-93

Pump Tank: Gallons; PT Date

Nitrification Field: No Fields 1 Square Feet 1200 Linear Feet 400

No Lines 4 Trench Width 3' Trench Depth 28-30" Gravel Depth 12"

☑ New System ☐ Repair System Type: I, (II), II, IV, V, VI

System Description: CONV - DIST. BOX

Repair System Description: PRESSURE PANEL

Maintenance Agreement Required: ☐ Yes ☑ No

☑ House/Mod. Home No. Bedrooms 3 Garbage Disposal: ☐ Yes ☑ No

☐ Mobile Home No. Bathrooms 2 Auto. Dishwasher: ☑ Yes ☐ No

☐ Business No. Employees Auto. Washing Machine: ☑ Yes ☐ No

☐ Other Other


☐ Slab ☑ Crawl Space ☐ Basement w/plumbing ☐ Basement wo/plumbing

Comments

KEEP PLUMBING SHALLOW IN ORDER TO MAINTAIN 28-30" TRENCH DEPTH

LINES ON SLOPE CONTOUR IN DIRECTION SHOWN.

INITIAL SITE SKETCH

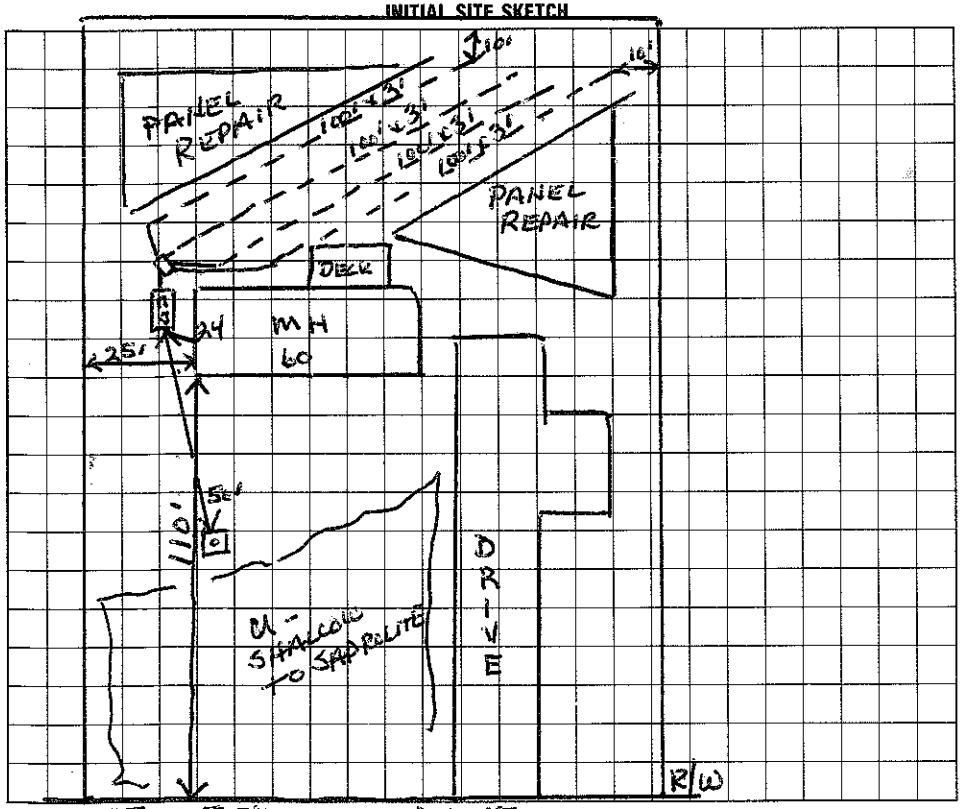

AS BUILT SKETCH

I understand that this permit is revoked or revoked if any false information is supplied toward securing the permit/any unauthorized changes are made to the site/any unauthorized changes are made in the installation of the system. Improvement Permit is valid for 60 months from date of issuance.

Signed: Elmer K Horton

Improvement Permit by: Wesley Sparks R.S. date 9/30/93

Existing System Inspection by: date

Installed by: Foster Pool Co.

Certificate of Completion by: Wesley Sparks R.S. date 10/18/93

Operation Permit by: date

HEALTH DEPT. COPY: WHITE INSPECTION COPY (FINAL): GREEN OWNER COPY (FINAL): YELLOW INSPECTION COPY (INITIAL): PINK OWNER COPY (INITIAL): GOLD