11.00

IREDELL COUNTY HEALTH DEPARTMENT

STATESVILLE 704-878-5305 MOORESVILLE 704-664-5281

IMPROVEMENT PERMIT / AUTHORIZATION TO CONSTRUCT / OPERATION PERMIT / EXISTING SYSTEM INSPE

PERMIT# 082 922 PIN# 4659553259 DATE 7/29/99

OWNER OR CONTRACTOR Scott Lute PHONE: Business Jim Peeler 528-3320 Home 660-6825

ADDRESS 180 Piedmont Point Dr Mooresville, NC 28115

LOCATION Hwy 115 N. TR Freeze Crossing at end on left

SUBDIVISION Freeze Crossing BLOCK / SECTION ____ LOT 15 LOT AREA .99 Acre SITE CLASS PS DESIGN FLOW 480gpd L.T.A.R. .3-.3+

Septic Tank: 1000 Gallons; STB 1012 Date 10/28/99
Pump Tank: ____ Gallons; PT ____ Date ____
Pump Make: ____ Model ____ Serial No. ____
Nitrification Field: No Fields 1 Square Feet 1590 Linear Feet 530'
No Lines 4 Trench Width 36" Max Trench Bottom Depth 24"-36" Gravel Depth 12"

☒ New System ☐ Repair System Type: I, II, III, IV, V, VI
System Description: Gravity Conventional
Repair System Description: Grav/Pump-Modified
Maintenance Agreement Required: ☐ Yes ☒ No

☐ House/Mod. Home No. Bedrooms 4
☒ Mobile Home No. Bathrooms 2
☐ Business No. Employees ____
☐ Other ____


☐ Slab ☒ Crawl Space ☐ Basement w/plumbing ☐ Basement wo/plumbing

Water Supply: ☒ Individual ☐ Public ☐ Community

Comments:/Conditions: Keep Septic System at least 10' from PL, 5' from House & at least 50' from any well. Locate well at least 25' from home & 40' from PL.

Comments:/Conditions: Total Lin. ft of Drainfield = 539' Well location changed to back left corner 50' from Septic System

INITIAL SITE SKETCH Scale 1"=60'

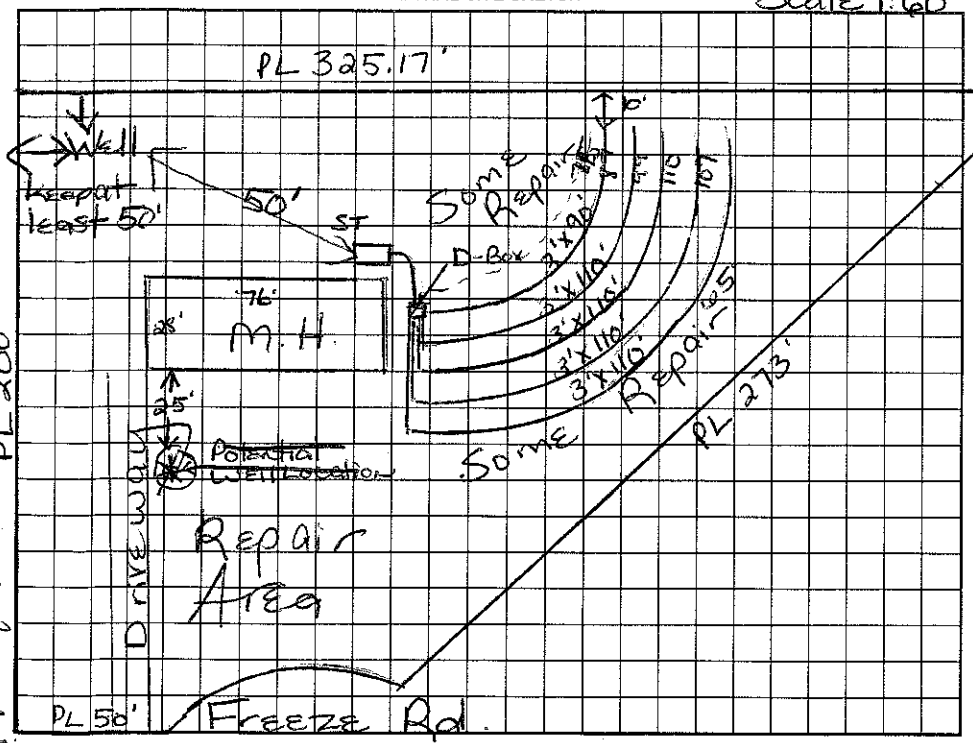

AS BUILT SKETCH

Permit can be suspended or revoked if any false information is supplied toward securing the permit/any unauthorized changes are made to the site/any unauthorized changes are made in the installation of the system. Improvement Permit with plat valid without expiration. Improvement Permit with site plan valid for sixty months. Authorization to Construct is valid for a period equal to that of Improvement Permit – not to exceed sixty months.

Signed: Jim Peeler date 7/29/99 Installed by: A-1 Backhoe

Improvement Permit by: Maint H.H. Dotson RS date 7/29/99 Operation Permit by: Maint H.H. Dotson RS date 9/3/99

Authorization to Construct by: Maint H.H. Dotson RS date 7/29/99 Existing System Inspection by: ____ date ____

HEALTH DEPT. COPY: WHITE OWNER COPY (FINAL): YELLOW OWNER COPY (INITIAL): PINK

11 87 gpd 112 PL 200' 107'