IREDELL COUNTY HEALTH DEPARTMENT

STATESVILLE 704-878-5305 MOORESVILLE 704-664-5281

IMPROVEMENT PERMIT / AUTHORIZATION TO CONSTRUCT / OPERATION PERMIT / EXISTING SYSTEM INSPECTION

PERMIT# 152663 PIN# 4659559348 DATE 9-15-2008

OWNER OR APPLICANT Buddy Scott PHONE: Business Home (704) 799-8524

ADDRESS 112 ORCHID LANE Mooresville, NC 28115

LOCATION 21 N FREEZE CROSSING TR TO END OF ROAD SITE ON LEFT

SUBDIVISION FREEZE CROSS BLOCK / SECTION LOT LOT AREA 23.43 AC SITE CLASS. PS DESIGN FLOW 360 L.T.A.R. .3 GPD/FT²

Septic Tank: 1000 Gallons; STB 1007 Date 9-11-08
Pump Tank: — Gallons; PT — Date —
Pump Make: — Model — Serial No. —
Nitrification Field: No Fields 1 Square Feet Linear Feet 300'
No Lines 3 Trench Width 36" Max Trench Bottom Depth 24" Gravel Depth

☒ New System ☐ Repair ☐ Expansion System Type: I II III IV V VI
System Description: 25% REDUCTION
Repair System Description: PPBPS 50% REDUCTION
Maintenance Agreement Required: ☐ Yes ☒ No

☒ House/Mod. Home No. Bedrooms 3
☐ Mobile Home No. Persons
☐ Business No. Employees
☐ Other


Water Supply: ☒ Individual ☐ Public ☐ Community

☒ Gravity ☐ Pressure ☐ Slab ☒ Crawl Space ☐ Basement w/plumbing ☐ Basement wo/plumbing


Comments:/Conditions: TANK & DRAINLINE MUST BE MINIMUM 5' FROM FOUNDATION. WELL MUST BE 100' FROM ANY SEPTIC SYSTEM.

Comments:/Conditions: DIVERT SURFACE DRAINAGE AWAY FROM SEPTIC AREA. NOSE SLOPE TO BE SHAVED DOWN TO CORRECT CONTOUR.

INITIAL SITE SKETCH

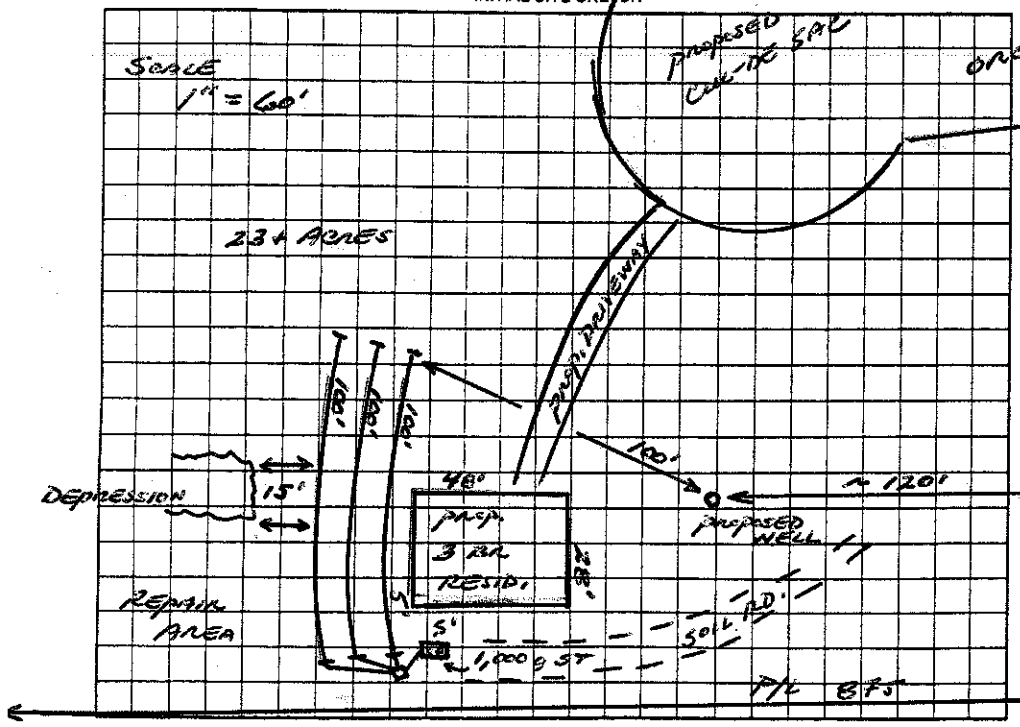

AS BUILT SKETCH

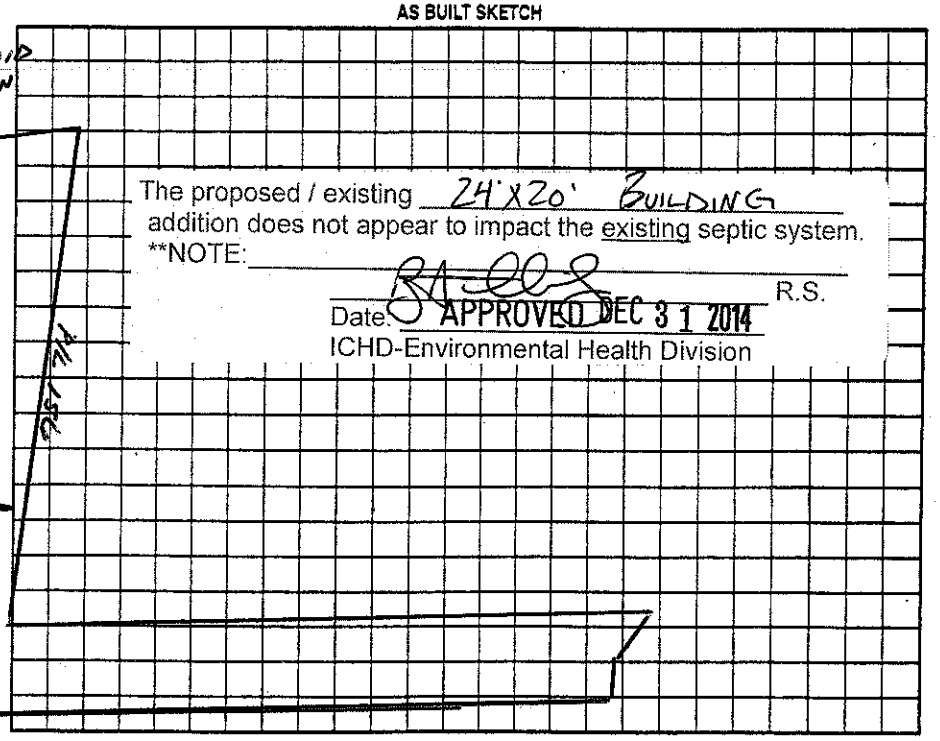

The proposed / existing 24'X20' BUILDING addition does not appear to impact the existing septic system.
**NOTE:

R.S.
Date: APPROVED DEC 31 2014
ICHD-Environmental Health Division

Permit can be suspended or revoked if any false information is supplied toward securing the permit/any unauthorized changes are made to the site/any unauthorized changes are made in the installation of the system. Improvement Permit with plat valid without expiration ☐ Improvement Permit with site plan valid for sixty months ☒ Authorization to Construct is valid for a period equal to that of Improvement Permit – not to exceed sixty months.

Signed: Buddy G. Scott date

Improvement Permit by: R.S. date 9-15-08

Authorization to Construct by: R.S. date 9-15-08

Installed by: UNIQUE PLANTS #1835

Operation Permit by: date 10-28-08

Existing System Inspection by: date

HEALTH DEPT. COPY: WHITE OWNER COPY (FINAL): YELLOW OWNER COPY (INITIAL): PINK