IREDELL COUNTY HEALTH DEPARTMENT

STATESVILLE 704-878-5305 MOORESVILLE 704-664-5281

IMPROVEMENT PERMIT / AUTHORIZATION TO CONSTRUCT / OPERATION PERMIT / EXISTING SYSTEM INSPECTION

PERMIT # 149307 PIN # 4659-56-3788 DATE 11-20-08

OWNER or APPLICANT WILLIAM ALLEN PHONE: Business 704-634-2310 Home:

OWNER or APPLICANT ADDRESS 111-B RACEWAY DR MOORESVILLE 28117

LOCATION / DIRECTIONS SHEPHERD RD, TL SHEPHERDS BLUFF, TL, CORNER OF SHEEP PATH & BLUFF MEADOW

SUBDIVISION SHEPHERDS BLUFF BLOCK / SECTION 5 LOT # 46 LOT AREA .55AC DESIGN FLOW 360 L.T.A.R. .3

Septic Tank 1000 Gallons: STB 1007 Date 10-6-09 ☒ New System ☐ Repair ☐ Expansion System Type I (II) III IV V VI

Pump Tank ____ Gallons: PT ____ Date ____ System Description: GRAVITY 25%

Pump Make ____ Model ____ Serial # ____ Repair System Description: LP-PANEL BLOCK

Nitrification Field No Fields 1 No Lines 5 Linear Feet 303' Maintenance Agreement Required ☐ YES ☒ NO INITIALLY

Trench Width 36" Max. Trench Bottom Depth 36" Gravel Depth — ☒ GRAVITY ☐ PRESSURE

☒ Residence No. Bedrooms 3 ☐ Business No. Persons ____ ☐ Other No. Employees ____ ☐ Slab ☒ Crawl Space ☐ Basement w/plumbing ☐ Basement w/o plumbing


Water Supply: ☒ Private ☐ Public ☐ Community

Comments / Conditions 1) DRAIN LINES MUST BE 100' FROM WELL 2) TANK MUST BE 50' FROM WELL 3) MEET ALL SETBACKS 4) USE DROP BOX DISTRIBUTION

Comments / Conditions

ST W/ MARKER

INITIAL SITE SKETCH

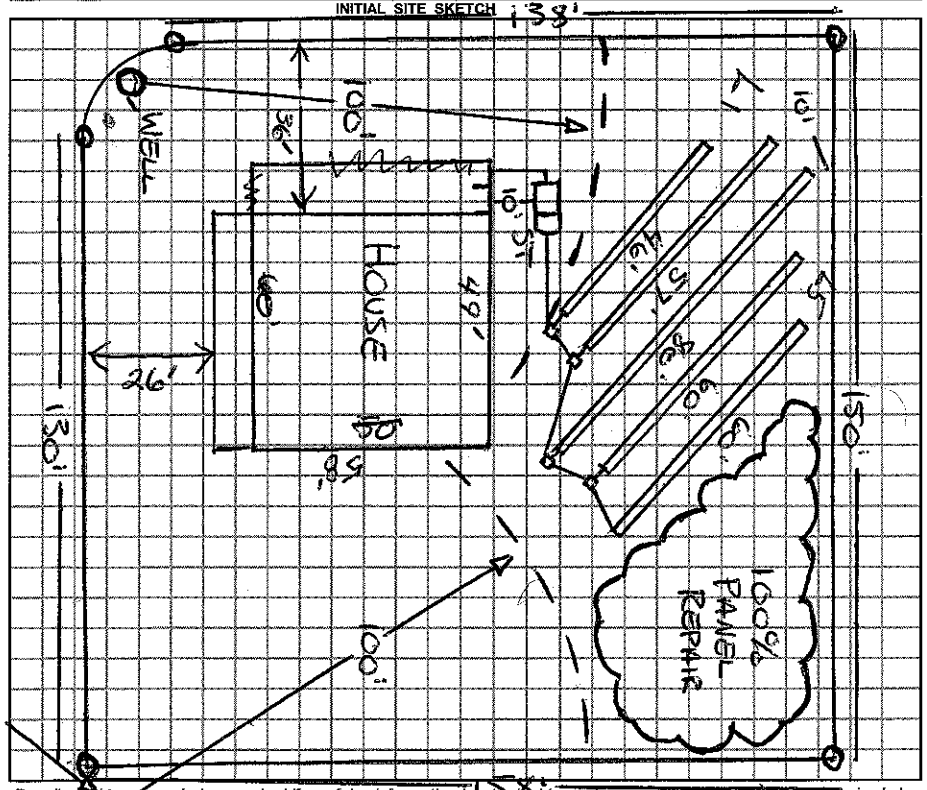

AS BUILT SKETCH

L1 36'
L2 68'
L3 72'
L4 172'
L5 52'

Installed Quick 4 Infiltrator

Installed essentially as drawn except for line lengths as specified

Well not installed at time of inspection

Permit can be suspended or revoked if any false information is supplied toward securing the permit / any unauthorized changes are made to the site / any unauthorized changes are made in the installation of the system.

☐ IMPROVEMENT PERMIT w / plat valid without expiration. ☒ IMPROVEMENT PERMIT w / site plan valid for 60 mos. ☐ AUTHORIZATION TO CONSTRUCT valid for period equal to IMPROVEMENT PERMIT-not to exceed 60 mo.

Owner / Applicant Signature: M. Scott McKnight Date 11/25/08

Improvement Permit by: B-A Date 11-20-08

Authorization to Construct by: Jerry Melville Date 11-13-09

YOU SHOULD CONTACT A LOCATOR SERVICE PRIOR TO ANY EXCAVATION.

Installed by: Johnson Excavating 3604 Level II

Operation Permit by: Jerry Melville Date: 12-11-09

Existing System Inspected by: ____ Date: ____

WHITE COPY Environmental Health YELLOW COPY (Final) Owner / Applicant PINK COPY (Initial) Owner / Applicant