IREDELL COUNTY HEALTH DEPARTMENT

Statesville Office (704) 878-5305 Mooresville Office (704) 660-3625 PERMIT # 208525

IMPROVEMENT PERMIT / AUTHORIZATION TO CONSTRUCT / OPERATION PERMIT / EXISTING SYSTEM

PIN # 4659-56-5976

APPLICANT: JERRY LYMAN/Robert Page APPLICANT ADDRESS: 120 CLIFFVIEW LN. MVILLE

SITE ADDRESS: 245 SHEPHERDS BLUFF DR. - Mooresville PHONE: 704-682-2993 ALT. PHONE:

SITE DIRECTIONS: 21N, SHEPHERD RD, TL SH. BLUFF, ON L


SUBDIVISION: SHEPHERD'S BLUFF SECTION: 4 LOT # 48 LOT AREA: .92 AC DESIGN FLOW: 480 L.T.A.R.: .3

Septic Tank	1000 (gal)	STB 794	Date 4-3-16	☒ New System ☐ Repair ☐ Expansion System Type: I II III IV V VI		☒ Residence	No. Bedrooms	4	Water Supply
Pump Tank	1000 (gal)	PT No Stamp	Date 4-6-16	System Description: PM - 25% REDUCTION		☐ Business	No. Persons	4	☒ Private
Pump Make	Myers	Model ME 40	Serial #	Repair System Description: LP PANEL BLOCK		☐ Other	No. Employees		☐ Public
# Nitrification Fields	1	# Lines 5	Linear Ft: 400'	Maintenance Agreement Required: ☐ YES ☒ NO		☐ Slab	☒ Crawl Space		☐ Community
Trench Width	36"	Max. Trench Bottom Depth * 26" *	Gravel Depth —	☐ GRAVITY ☒ PRESSURE		☐ Basement w/plumbing	☒ Basement w/o plumbing		


Comments / Conditions: 12/17/15 Revised floor plans submitted in compliance with Improvement permit

7/21/16 Checked pressure (2 ft), elect & alarm

INITIAL SITE SKETCH

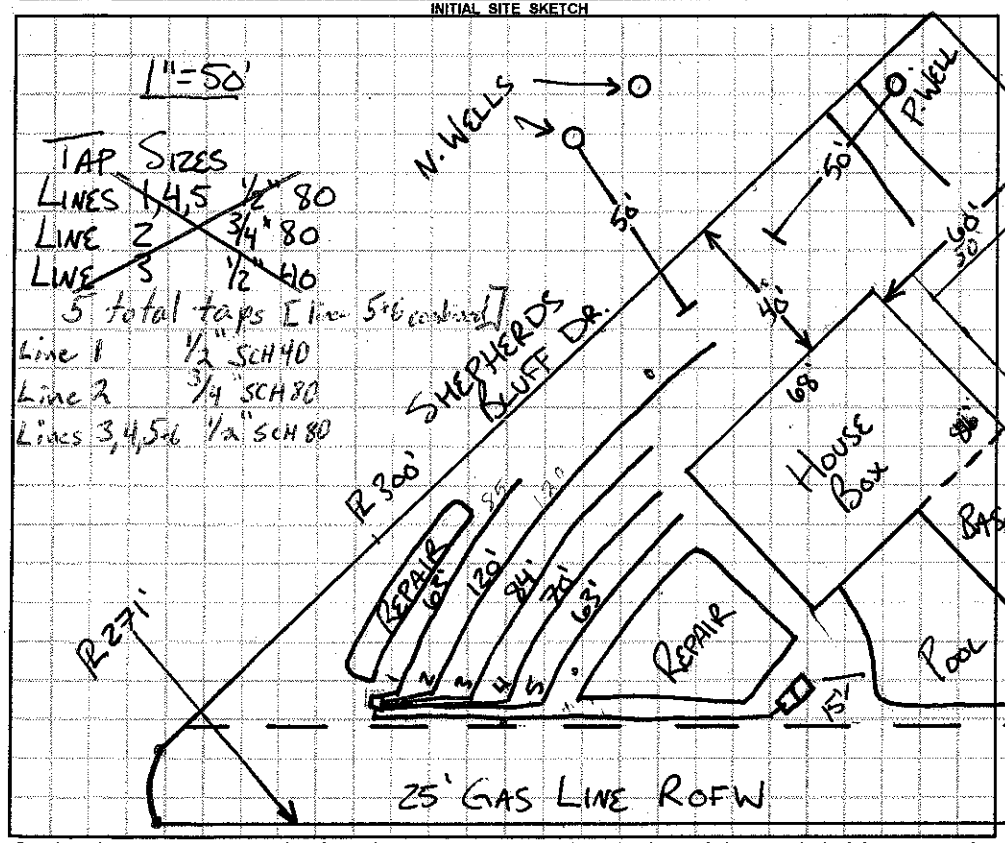

AS BUILT SKETCH

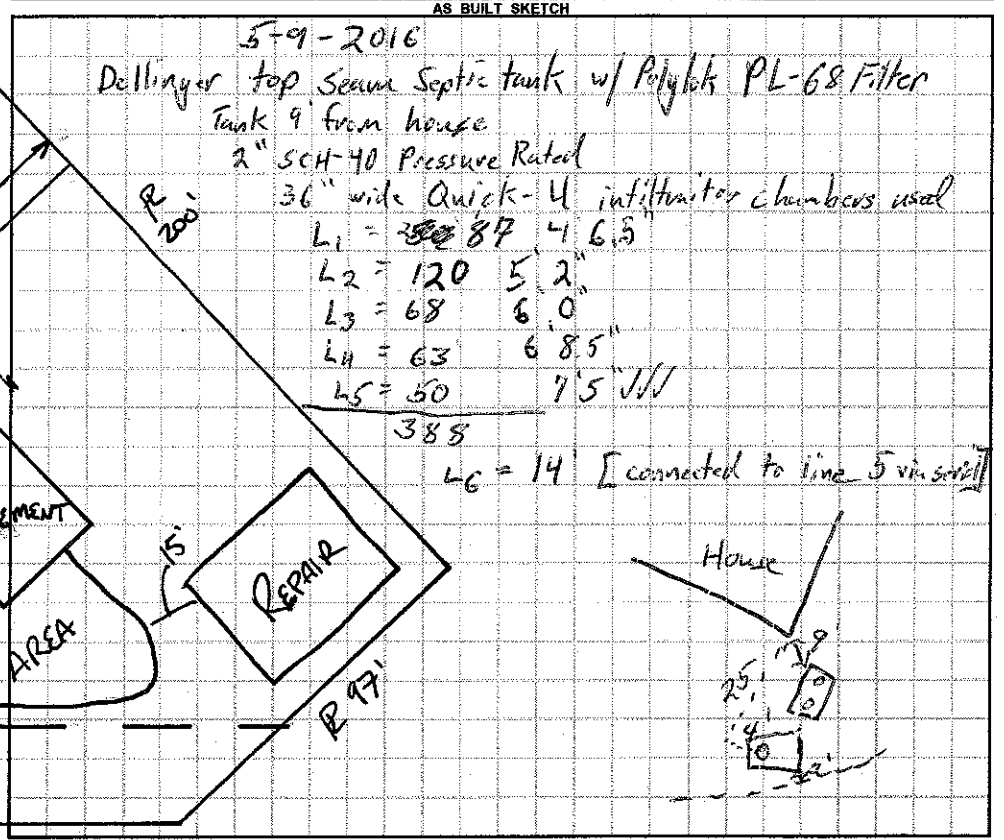

Permit can be suspended or revoked if any false information is supplied toward securing the permit / any unauthorized changes are made to the site / any unauthorized changes are made in the installation of the system. **CONTACT A LOCATOR SERVICE PRIOR TO ANY EXCAVATION**

☐ **IMPROVEMENT PERMIT** *with plat valid without expiration.* ☐ **IMPROVEMENT PERMIT** *with site plan valid for 60 mos.* ☒ **AUTHORIZATION TO CONSTRUCT** *valid for period equal to IMPROVEMENT PERMIT--not to exceed 60 mo.*

Owner / Applicant Signature: Jennifer Pennington Date: 9-16-15 Installed by: Specialty Septic

IMPROVEMENT PERMIT by: APPROVED Date: APR 02 2015 OPERATION PERMIT by: Maria Dobson RS Date: 7/21/16

AUTHORIZATION TO CONSTRUCT by: APPROVED Date: APR 02 2015 Existing System Inspected by: Date:

Health Dept. Copy - WHITE Applicant (Final Approval) - YELLOW Applicant (Conditional Approval) - PINK