2100

IREDELL COUNTY HEALTH DEPARTMENT

STATESVILLE 704-878-5305 MOORESVILLE 704-664-5281

IMPROVEMENT PERMIT / AUTHORIZATION TO CONSTRUCT / OPERATION PERMIT / EXISTING SYSTEM INSPECTION

PERMIT# 140420 PIN# ~~4659-56-7605~~ 4659-56-7416 DATE 2/6/07

OWNER OR APPLICANT Shepherds Bluff LLC / L. Shaun Ogle PHONE: Business _____ Home _____

ADDRESS 111 B Raceway Dr. Mooresville, NC. 28117

LOCATION 115 NTR Shepherd Rd TL Shepherds Bluff TL Meadow Bluff TL on Sheep Path, lot on (R)

SUBDIVISION Shepherds Bluff BLOCK / SECTION _____ LOT Lo LOT AREA 1.44Ac SITE CLASS PS DESIGN FLOW 480 L.T.A.R. .3

Septic Tank: 1000 Gallons; STB 794 Date 7/21/07
Pump Tank: 1000 Gallons; PT 27 Date 6/17/07
Pump Make Goulds Model PE5IM Serial No. _____
Nitrification Field: No Fields ___ Square Feet 840 Linear Feet 267
No Lines 4@70 Trench Width 3' Max Trench Bottom Depth 3'

[X] New System [ ] Repair [ ] Expansion System Type: I II III (IV) V VI
System Description: Pressure Dosed - 16" PPBPS
Repair System Description: Same
Maintenance Agreement Required: [X] Yes [ ] No

[X] House/Mod. Home No. Bedrooms 4
[ ] Mobile Home No. Persons ___
[ ] Business No. Employees ___
[ ] Other _____

Water Supply: [X] Individual [ ] Public [ ] Community

Gravel Depth No [ ] Gravity [X] Pressure [ ] Slab [ ] Crawl Space [ ] Basement w/plumbing [X] Basement w/o plumbing PARTIAL

Comments:/Conditions: System design prepared by Rollins Soil & Environmental Services.

Comments:/Conditions: Reviewed plans, essentially in compliance with original permit
* Must plug property line with plaster


INITIAL SITE SKETCH

(1) Must have Rollins Specifications and Site Plan before attempting installation of this system.

(2) House plan must be approved by ICHD before Auth. to Construct will be issued.

AS BUILT SKETCH

Drainlines checked 8/29/07 L.C. Now well onsite at time of inspection
5/32" holes in panels

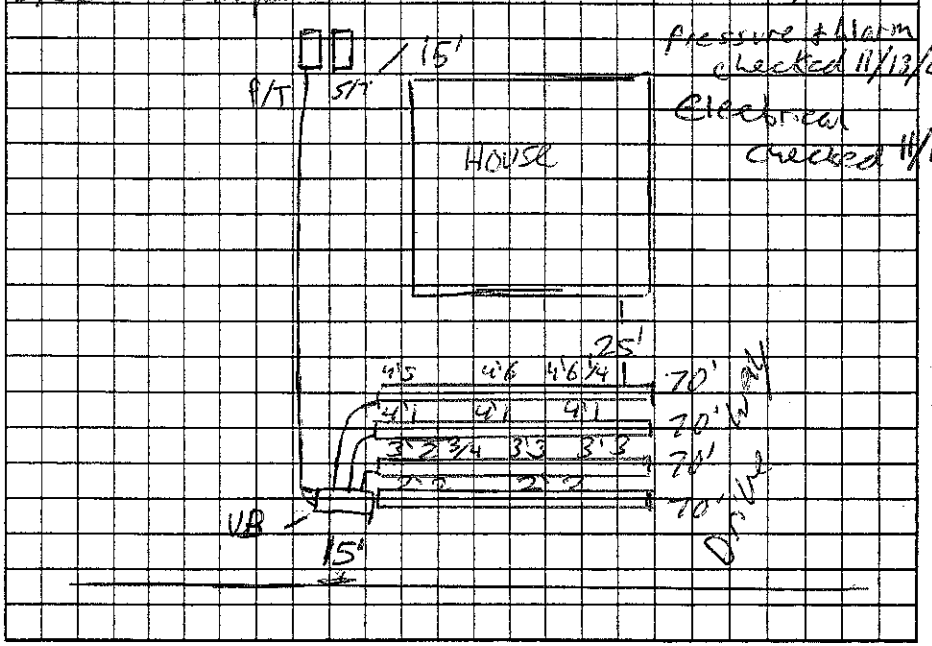

Pressure & Alarm checked 11/13/07
Electrical checked 11/15/07

Permit can be suspended or revoked if any false information is supplied toward securing the permit/any unauthorized changes are made to the site/any unauthorized changes are made in the installation of the system. Improvement Permit with plat valid without expiration ☐ Improvement Permit with site plan valid for sixty months ☐ Authorization to Construct is valid for a period equal to that of Improvement Permit – not to exceed sixty months.

Signed: _____ date 2/9/07 Installed by: Abernathy Septic

Improvement Permit by: Wesley Stephens RS date 2/6/07 Operation Permit by: Anthony Coker date 11/19/07

Authorization to Construct by: Maria H. Watson RS date 2/19/07 Existing System Inspection by: _____ date _____

HEALTH DEPT. COPY: WHITE OWNER COPY (FINAL): YELLOW OWNER COPY (INITIAL): PINK