IREDELL COUNTY HEALTH DEPARTMENT

Statesville Office (704) 878-5305 Mooresville Office (704) 660-3625 PERMIT # 208041

IMPROVEMENT PERMIT / AUTHORIZATION TO CONSTRUCT / OPERATION PERMIT / EXISTING SYSTEM

PIN # 4659567914

APPLICANT: Curtis Barteau APPLICANT ADDRESS: 111 Shining Armor Ct Mooresville, NC

SITE ADDRESS: 241 Shepherds Bluff Mooresville, NC 28115 PHONE: ALT. PHONE:

SITE DIRECTIONS: Hwy 115 N TR Shepherd Rd TL Shepherd's Bluff on left

SUBDIVISION: Shepherd's Bluff SECTION: 4 LOT # 49 LOT AREA: DESIGN FLOW: 360gpd L.T.A.R.: .25

Septic Tank	1000 (gal)	STB	794	Date	8-16-16	[X] New System [ ] Repair [ ] Expansion	System Type: I II III IV V VI	[X] Residence	No. Bedrooms 3
Pump Tank	(gal)	PT		Date		System Description:	Gravity -25% Reduction	[ ] Business	No. Persons 6
Pump Make		Model		Serial #		Repair System Description:		[ ] Other	No. Employees
# Nitrification Fields	1	# Lines	6	Linear Ft:	372	Maintenance Agreement Required:	[ ] YES [X] NO	[ ] Slab	[X] Crawl Space
Trench Width	36"	Max. Trench Bottom Depth	18"I / 30"R	Gravel Depth	N/A	[X] GRAVITY	[ ] PRESSURE	[ ] Basement w/plumbing	[ ] Basement w/o plumbing

Water Supply: [X] Private [ ] Public [ ] Community

Comments / Conditions: 8 1/2' from bumpout on house to edge of ST.

* Must divert stormwater & surface water away from Septic System. Site requires French drain along PL.

INITIAL SITE SKETCH

See Attached, Approved plan by Rollans Soil & Environmental Services, PA (dated 5/12/16)

AS BUILT SKETCH

10/13/16 Checked top 4 lines

10/14/16 Checked last 2 lines & French drain

Permit can be suspended or revoked if any false information is supplied toward securing the permit / any unauthorized changes are made to the site / any unauthorized changes are made in the installation of the system. **CONTACT A LOCATOR SERVICE PRIOR TO ANY EXCAVATION**

[ ] **IMPROVEMENT PERMIT** *with plat valid without expiration.* [ ] **IMPROVEMENT PERMIT** *with site plan valid for 60 mos.* [ ] **AUTHORIZATION TO CONSTRUCT** *valid for period equal to IMPROVEMENT PERMIT--not to exceed 60 mo.*

Owner / Applicant Signature: Curtis Barteau Date: 6/3/16

IMPROVEMENT PERMIT by: Myra Dotson RS Date: 5/26/16


AUTHORIZATION TO CONSTRUCT by: Myra Dotson RS Date: 5/26/16

Installed by: Specialty Septic

OPERATION PERMIT by: Myra Dotson RS Date: 10/14/16

Existing System Inspected by: Date:

Health Dept. Copy - WHITE Applicant (Final Approval) - YELLOW Applicant (Conditional Approval) - PINK

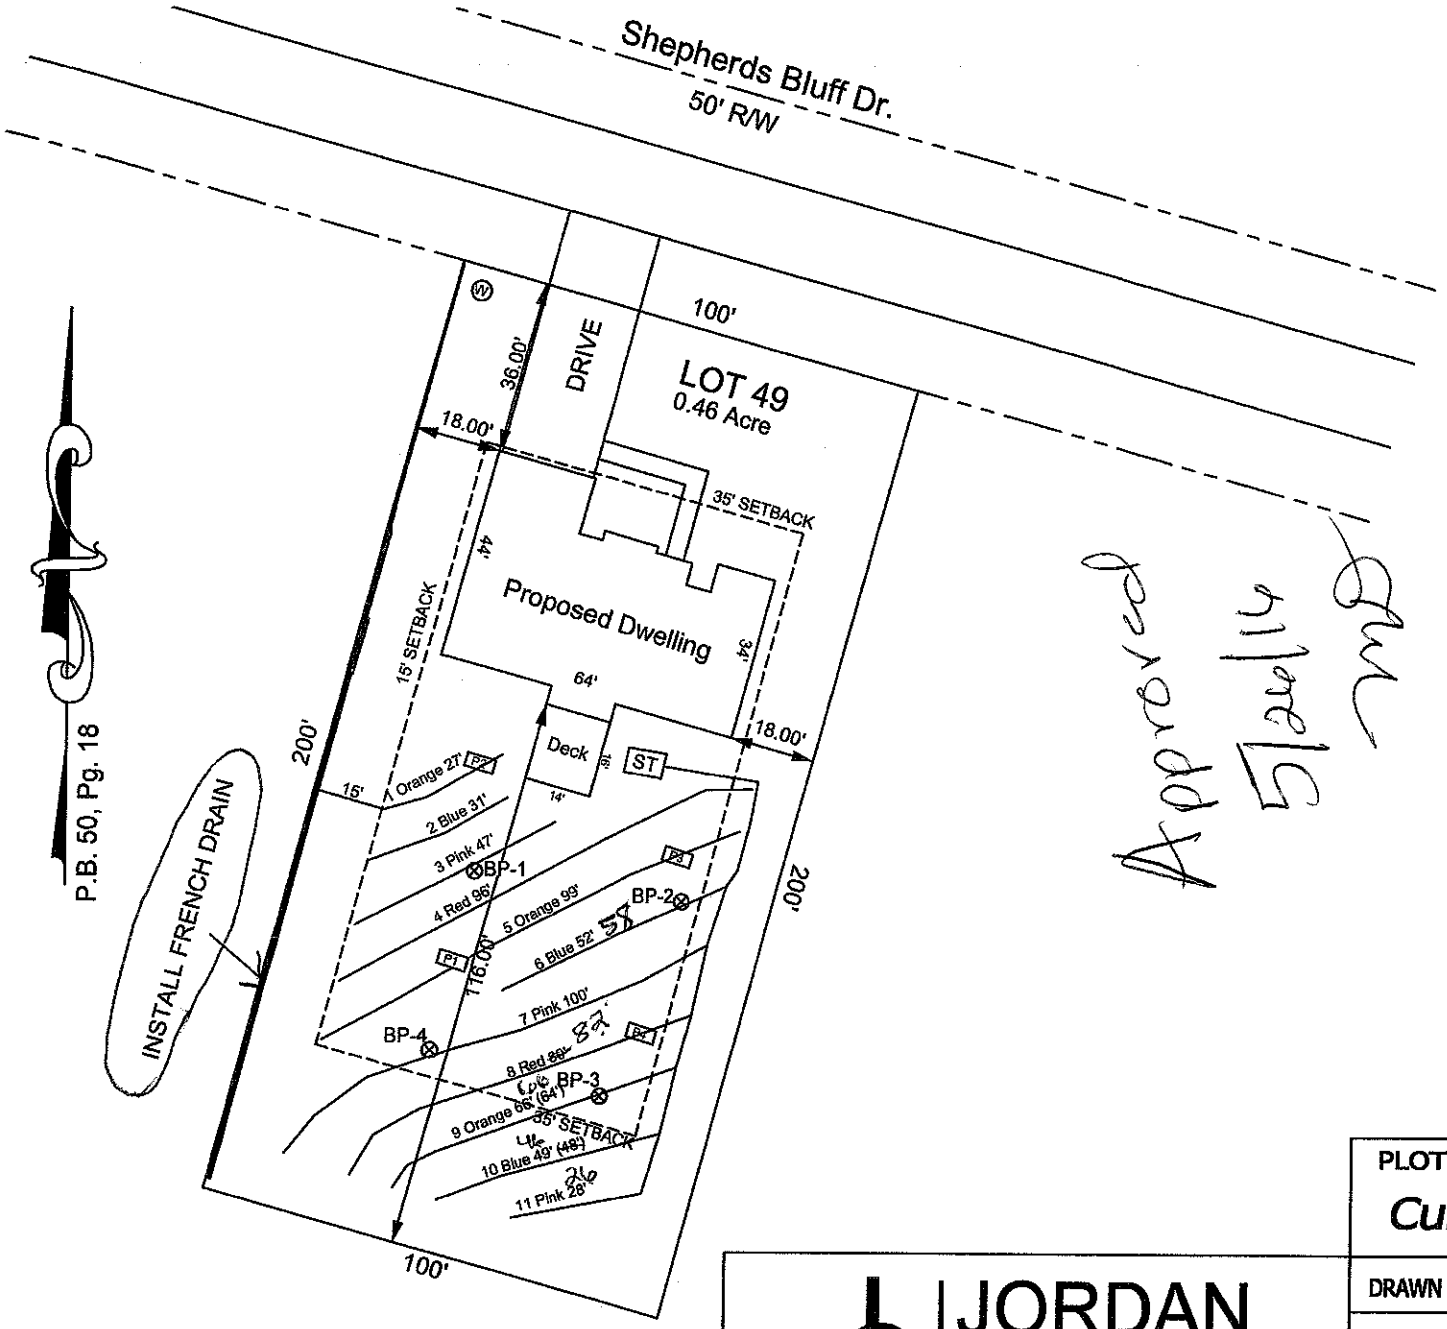

JORDAN GRANT

ENGINEERING • SURVEYING • PLANNING
JORDAN GRANT & ASSOCIATES, PLLC
P.O. BOX 151 * STATESVILLE, NC 28687
mattg@jordan-grant.com (704) 928-7919
FIRM # P-1227

PLOT PLAN FOR:

Curtis & Barbara Barteau

DRAWN BY: MIG	CHECKED BY: WMJ
SCALE: 1"=40'	
DEED REF: 2270-1361	PIN NO: 4659-56-7914
DATE OF MAP: 02-29-16	SURVEY DATE:
REVISION: 05-10-16	DRAWING FILE: 20160206

241 SHEPHERDS BLUFF DR, MOORESVILLE, NC 28117
BARRINGER TOWNSHIP --- IREDELL COUNTY --- NORTH CAROLINA