IREDELL COUNTY HEALTH DEPARTMENT

STATESVILLE 704-878-5305 MOORESVILLE 704-664-5281

IMPROVEMENT PERMIT / AUTHORIZATION TO CONSTRUCT / OPERATION PERMIT / EXISTING SYSTEM INSPECTION

PERMIT# 138562 PIN# 4659569896 DATE 11-13-06

OWNER OR APPLICANT Shepherd's Bluff LLC PHONE: Business 664-7029 Home

ADDRESS 111-B Raceway Drive, Mooresville, NC 28117

LOCATION US 21 N TR Shepherds Rd to Shepherd's Bluff Dr on left

SUBDIVISION Shepherd's Bluff BLOCK / SECTION LOT 52 LOT AREA .46 Acre SITE CLASS. PS DESIGN FLOW 480gpd L.T.A.R. .3

Septic Tank: 1000 Gallons; STB 1012 Date 11-14-06
Pump Tank: Gallons; PT Date
Pump Make: Model Serial No.
Nitrification Field: No Fields 1 Square Feet 1200+ Linear Feet 400'
No Lines 5@80 Trench Width 36" Max Trench Bottom Depth 42"

☒ New System ☐ Repair ☐ Expansion System Type: I II III IV V VI
System Description: Gravity-Conventional "Accepted"
Repair System Description: DP- Panel Block
Maintenance Agreement Required: ☐ Yes ☐ No

☒ House/Mod. Home No. Bedrooms 4
☐ Mobile Home No. Persons
☐ Business No. Employees
☐ Other


Water Supply: ☒ Individual ☐ Public ☐ Community

Gravel Depth N/A ☒ Gravity ☐ Pressure ☐ Slab ☒ Crawl Space ☐ Basement w/plumbing ☐ Basement wo/plumbing

Comments/Conditions: Septic Plan submitted by Rollins Environmental attached

Comments/Conditions: Note: "Accepted" = 25% Reduction. Use "One piece" ST for ≤ 100ft to well
11/14/06 Reviewed Floor plans, in Compliance with I.P.

Scale 1:50 INITIAL SITE SKETCH

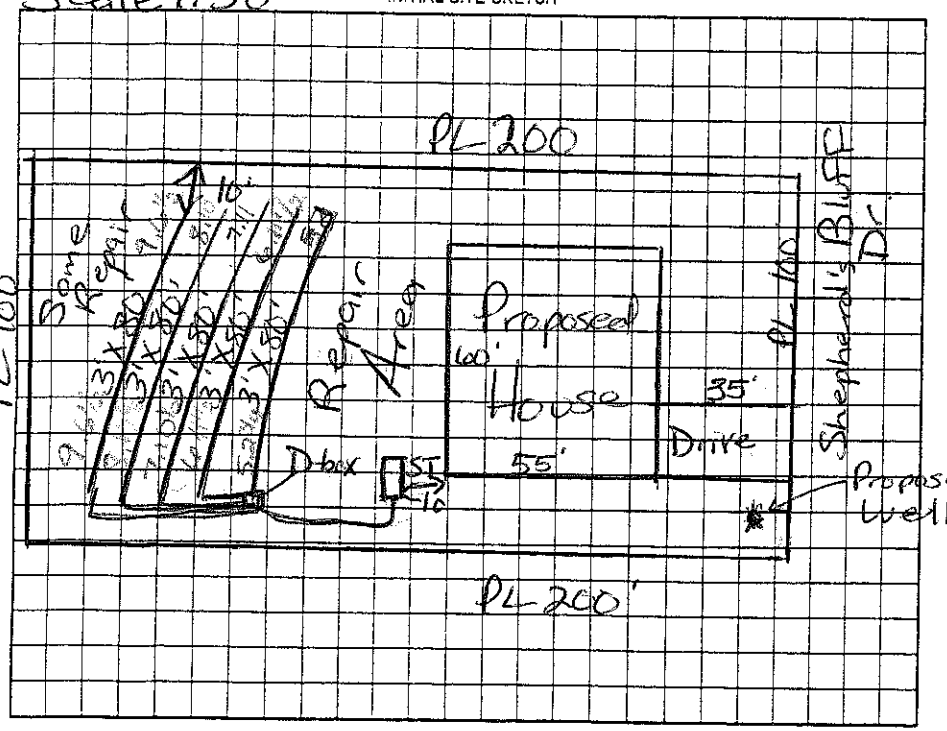

AS BUILT SKETCH

Installed Quick 4

Saprolite - 150' well setback

Permit can be suspended or revoked if any false information is supplied toward securing the permit/any unauthorized changes are made to the site/any unauthorized changes are made in the installation of the system. Improvement Permit with plat valid without expiration ☐ Improvement Permit with site plan valid for sixty months ☐ Authorization to Construct is valid for a period equal to that of Improvement Permit - not to exceed sixty months.

Signed: [signature]

Improvement Permit by: Maria H. Rollins RS date 11/13/06

Authorization to Construct by: Maria H. Rollins RS date 11/14/06

Installed by: Piedmont Backhoe

Operation Permit by: Maria H. Rollins RS date 5/1/07

Existing System Inspection by: date

HEALTH DEPT. COPY: WHITE OWNER COPY (FINAL): YELLOW OWNER COPY (INITIAL): PINK