IREDELL COUNTY HEALTH DEPARTMENT

STATESVILLE 704-878-5305 MOORESVILLE 704-664-5281

IMPROVEMENT PERMIT / AUTHORIZATION TO CONSTRUCT / OPERATION PERMIT / EXISTING SYSTEM INSPECTION

PERMIT# 137393 PIN# 4659,66 1703.024 4659-57-6189 DATE 8/14/06

OWNER OR APPLICANT Shepherds Bluff LLC/ASHCRAFT CUSTOM HOMES PHONE: Business Home

ADDRESS 111-B Rockway Dr Mooresville NC 28117

LOCATION 115 N TR Shepherds, TL Shepherds Bluff on Rt

SUBDIVISION Shepherds Bluff BLOCK / SECTION 4 LOT 24 LOT AREA 0.46 ac SITE CLASS. PS DESIGN FLOW 360 L.T.A.R. 0.275

Septic Tank: 1000 Gallons; STB 794 Date 1/11/08
Pump Tank: 1000 Gallons; PT 983 Date 3/7/08
Nitrification Field: No Fields 1 Square Feet 450 Linear Feet 225
No Lines 3@75' Trench Width 24" Max Trench Bottom Depth 36" Gravel Depth — ☐ Gravity ☒ Pressure

☒ New System ☐ Repair ☐ Expansion System Type: I II III (IV) V VI
System Description: LP panel Block
Repair System Description: Same
Maintenance Agreement Required: ☐ Yes ☐ No

☒ House/Mod. Home No. Bedrooms 3
☐ Mobile Home No. Persons
☐ Business No. Employees
☐ Other

Water Supply: ☒ Individual ☐ Public ☐ Community

☐ Slab ☒ Crawl Space ☐ Basement w/plumbing ☐ Basement wo/plumbing


Comments:/Conditions:

Comments:/Conditions:
Red Filter

INITIAL SITE SKETCH

SEE ATTACHED PLAN BY
ROLLINS SOIL +
ENVIRONMENTAL SERVICES

AS BUILT SKETCH

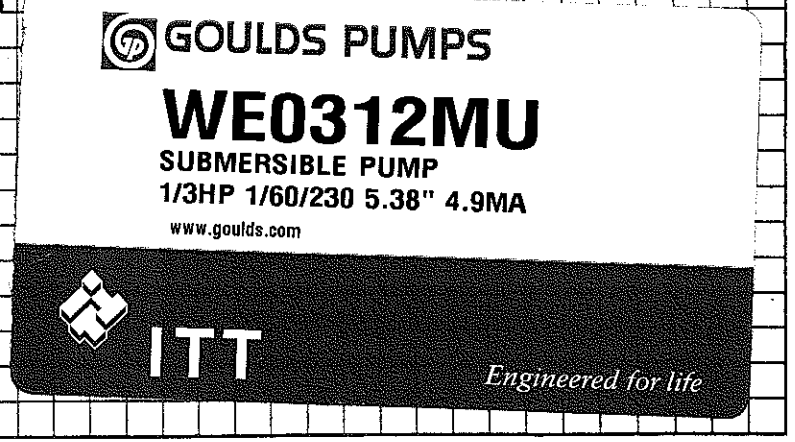

Permit can be suspended or revoked if any false information is supplied toward securing the permit/any unauthorized changes are made to the site/any unauthorized changes are made in the installation of the system. Improvement Permit with plat valid without expiration ☐ Improvement Permit with site plan valid for sixty months ☐ Authorization to Construct is valid for a period equal to that of Improvement Permit – not to exceed sixty months.

Signed: [signature] date 8/18/06 Installed by: David Yountz

Improvement Permit by: [signature] RS date 8/14/06 Operation Permit by: [signature] date 6/16/08

Authorization to Construct by: [signature] MS date 10/15/07 Existing System Inspection by: date

HEALTH DEPT. COPY: WHITE OWNER COPY (FINAL): YELLOW OWNER COPY (INITIAL): PINK