320 - FAST TRACK ARP

IREDELL COUNTY HEALTH DEPARTMENT

Statesville Office (704) 878-5305 Mooresville Office (704) 660-3625 PERMIT # 208042

IMPROVEMENT PERMIT / AUTHORIZATION TO CONSTRUCT / OPERATION PERMIT / EXISTING SYSTEM

PIN # 4659578175

APPLICANT: Blair Builders APPLICANT ADDRESS: P.O. Box 4569 Mooresville, NC 28117

SITE ADDRESS: 2336 Shepherd's Bluff Dr. Mooresville, NC PHONE: ALT. PHONE: 704 609-3157

SITE DIRECTIONS: Hwy 115 N TR Shepherd's Rd TL Shepherd's Bluff lot on right


SUBDIVISION: Shepherd's Bluff SECTION: 4 LOT # 22 LOT AREA: .46 Acre DESIGN FLOW: 480gpd L.T.A.R.: .35

Septic Tank	1000 (gal)	STB	786	Date	6/2/15	☒ New System ☐ Repair ☐ Expansion	System Type: I II III IV V VI	☒ Residence	No. Bedrooms	4	Water Supply
Pump Tank	1000 (gal)	PT	32	Date	3/24/15	System Description: Pump-PM-25% Reduction		☐ Business	No. Persons	8	☒ Private
Pump Make	Cavas	Model	VLTG 511N	Serial #		Repair System Description: PPBPS		☐ Other	No. Employees		☐ Public
# Nitrification Fields	1	# Lines	5	Linear Ft.	348*	Maintenance Agreement Required: ☐ YES ☒ NO Not Initially		☐ Slab	☒ Crawl Space		☐ Community
Trench Width	36"	Max. Trench Bottom Depth	36"	Gravel Depth	N/A	☐ GRAVITY ☒ PRESSURE		☐ Basement w/plumbing	☐ Basement w/o plumbing		


Comments / Conditions: * 348ft Drainline required
** Must stub out plumbing high to Maintain Gravity flow to ST

Note: Must stay 100ft from wells, Septic is in SAP.

INITIAL SITE SKETCH

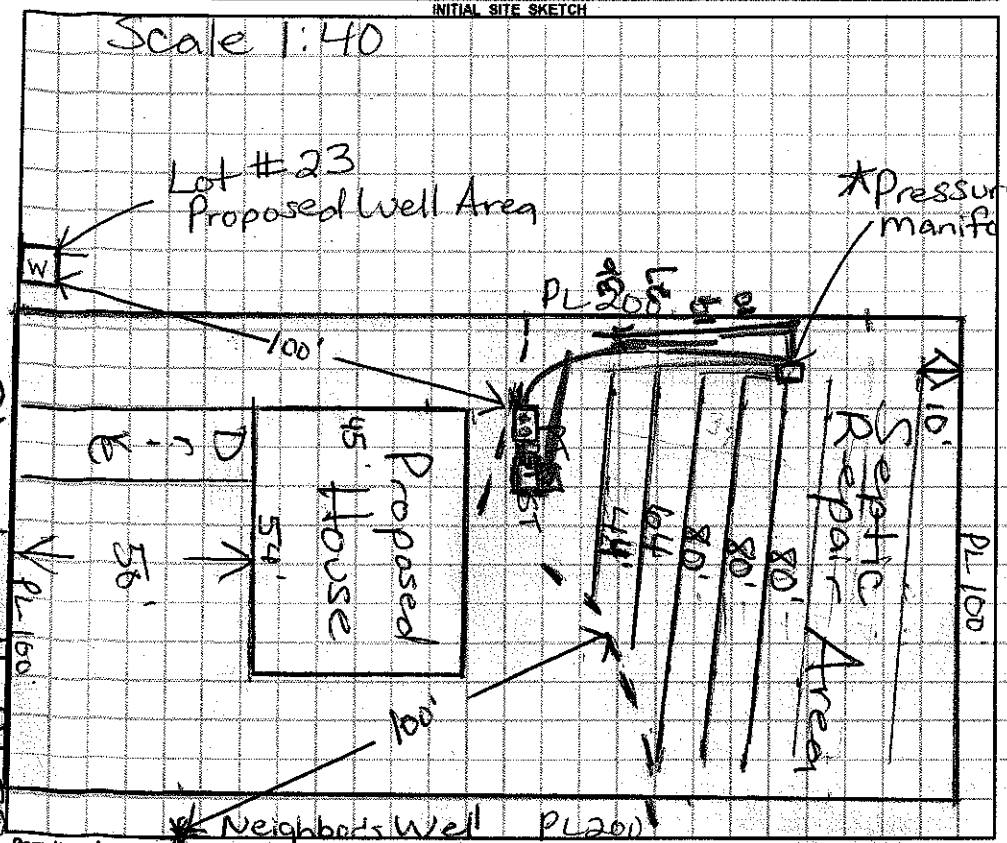

AS BUILT SKETCH

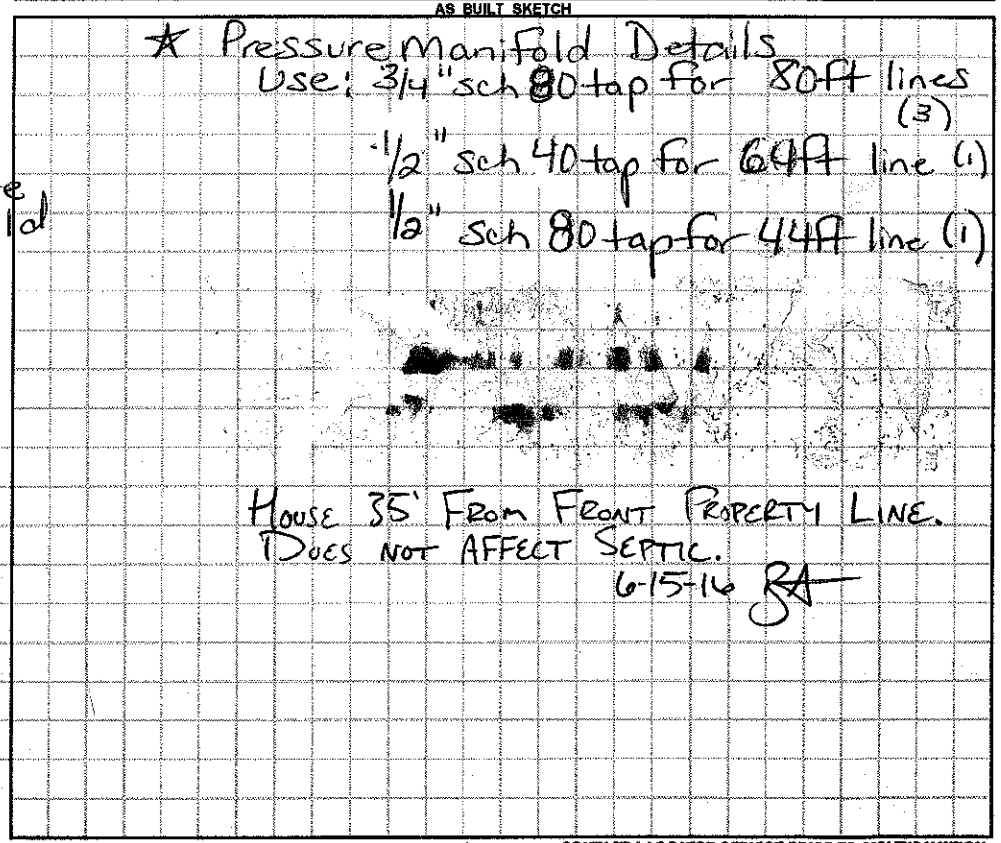

Permit can be suspended or revoked if any false information is supplied toward securing the permit / any unauthorized changes are made to the site / any unauthorized changes are made in the installation of the system. CONTACT A LOCATOR SERVICE PRIOR TO ANY EXCAVATION

☐ IMPROVEMENT PERMIT *with plat* valid without expiration. ☐ IMPROVEMENT PERMIT *with site plan* valid for 60 mos. ☒ AUTHORIZATION TO CONSTRUCT valid for period equal to IMPROVEMENT PERMIT--not to exceed 60 mo.

Owner / Applicant Signature: Chloe Jones Date: 5/8/15 Installed by: Adam Bowden

IMPROVEMENT PERMIT by: Maria Dolan RS Date: 3/18/15 OPERATION PERMIT by: Maria Dolan RS Date: 12/5/16

AUTHORIZATION TO CONSTRUCT by: APPROVED Date: JUN 15 2016 Existing System Inspected by: Date:

Health Dept. Copy - WHITE Applicant (Final Approval) - YELLOW Applicant (Conditional Approval) - PINK

10:00

	Date	Initials
Drain Lines Checked	10/17	CCS
Tanks Checked	10/17	"
Pressure Manifold or Valve Box Checked		
Pressure Head Set		
Electrical Checked		
Floats Set		
Alarm Checked		
Maintenance Contract Y / N		
Comments:		