2330

COBBLECREEK BUILDERS

IREDELL COUNTY HEALTH DEPARTMENT

STATESVILLE 704-878-5305 MOORESVILLE 704-664-5281

IMPROVEMENT PERMIT / AUTHORIZATION TO CONSTRUCT / OPERATION PERMIT / EXISTING SYSTEM INSPECTION

PERMIT# 138561 PIN# 4659579162 DATE 11-13-06

OWNER OR APPLICANT Shepherd's Bluff LLC PHONE: Business 664-7029 Home

ADDRESS 111-B Raceway Drive Mooresville, NC 28117

LOCATION US 21 North TR Shepherd's Rd TL Shepherd's Bluff Dr. on right

SUBDIVISION Shepherd's Bluff BLOCK / SECTION 4 LOT 21 LOT AREA .46 Acre SITE CLASS PS DESIGN FLOW 480 gpd L.T.A.R. .35

Septic Tank: 1000 Gallons; STB 1012 Date 10-30-06
Pump Tank: 1000 Gallons; PT 17 Date 1-18-07
Pump Make: Goulds Model WE05512HH No. D076737
Nitrification Field: No Fields 1 Square Feet 720 Linear Feet 240
No Lines 6 @ 40' Trench Width See plan Max Trench Bottom Depth 42" Gravel Depth N/A

☒ New System ☐ Repair ☐ Expansion System Type: I II III IV V VI
System Description: Pump - Panel Block
Repair System Description: Same
Maintenance Agreement Required: ☒ Yes ☐ No


☒ House/Mod. Home No. Bedrooms 4
☐ Mobile Home No. Persons
☐ Business No. Employees
☐ Other

Water Supply: ☒ Individual ☐ Public ☐ Community

☐ Gravity ☐ Pressure ☐ Slab ☒ Crawl Space ☐ Basement w/plumbing ☐ Basement wo/plumbing

Comments/Conditions: See Approved plan by Rollans Environmental; attached Use filter on PT Checked tanks & lines 5/3/07

INITIAL SITE SKETCH

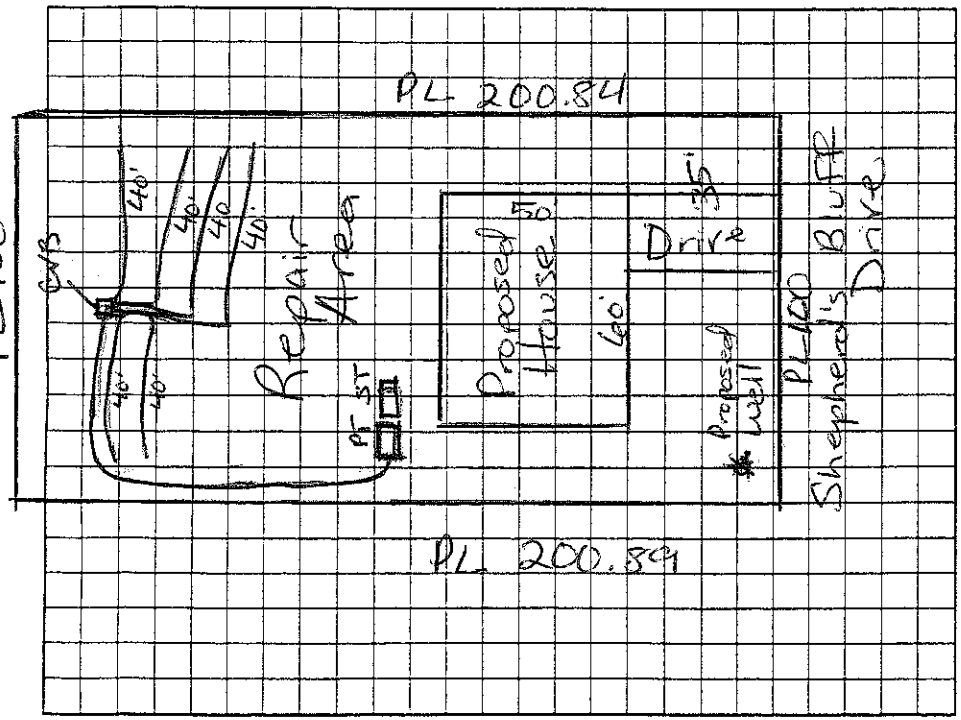

Comments/Conditions: Note: Use "One piece" ST & PT if less than 100ft to well. Renewed plans 11/14/06 in Compliance with original permit

AS BUILT SKETCH

Drilled 3/16" hole 54 Panels total 9 per clitch

Permit can be suspended or revoked if any false information is supplied toward securing the permit/any unauthorized changes are made to the site/any unauthorized changes are made in the installation of the system. Improvement Permit with plat valid without expiration ☐ Improvement Permit with site plan valid for sixty months ☐ Authorization to Construct is valid for a period equal to that of Improvement Permit – not to exceed sixty months.

Signed: [signature] date 11/14/06 Installed by: Steve Jordan

Improvement Permit by: Maina H. Dotson RS date 11/13/06 Operation Permit by: Wesley Sparks R.S. date 7/3/07

Authorization to Construct by: Maina H. Dotson RS date 11/14/06 Existing System Inspection by: date

HEALTH DEPT. COPY: WHITE OWNER COPY (FINAL): YELLOW OWNER COPY (INITIAL): PINK