IREDELL COUNTY HEALTH DEPARTMENT

STATESVILLE 704-878-5305 MOORESVILLE 704-664-5281

IMPROVEMENT PERMIT / AUTHORIZATION TO CONSTRUCT / OPERATION PERMIT / EXISTING SYSTEM INSPECTION

23 pm

PERMIT# 087547 PIN# 4659 60 4336 DATE 1/19/2000

OWNER OR CONTRACTOR Elston Hedges PHONE: Business 954-434-6357 Home

ADDRESS 9400 SW 51 ST ST. Cooper City, Fla. 33328

LOCATION 115-21N LOT ON (L) just before Shepard School - 1764 Charlotte Hwy.

SUBDIVISION BLOCK / SECTION LOT LOT AREA 10.3 AC SITE CLASS. DESIGN FLOW 360 L.T.A.R. .3

Septic Tank: 1000 Gallons; STB 312 Date 12/14/99

Pump Tank: Gallons; PT Date

Pump Make: Model Serial No.

Nitrification Field: No Fields 1 Square Feet 900* Linear Feet 300*

No Lines 4 Trench Width 36" Max Trench Bottom Depth 36" Gravel Depth SAND

[X] New System [ ] Repair System Type: I, II, (III) IV, V, VI

System Description: GRAV-CH: PLASTIC

Repair System Description:

Maintenance Agreement Required: [ ] Yes [X] No

[ ] House/Mod. Home No. Bedrooms 3

[X] Mobile Home No. Bathrooms 2

[ ] Business No. Employees

[ ] Other


[ ] Slab [X] Crawl Space [ ] Basement w/plumbing [ ] Basement wo/plumbing

Water Supply: [X] Individual [ ] Public [ ] Community

Comments:/Conditions:

PROPOSED HOUSE LOCATION


INITIAL SITE SKETCH

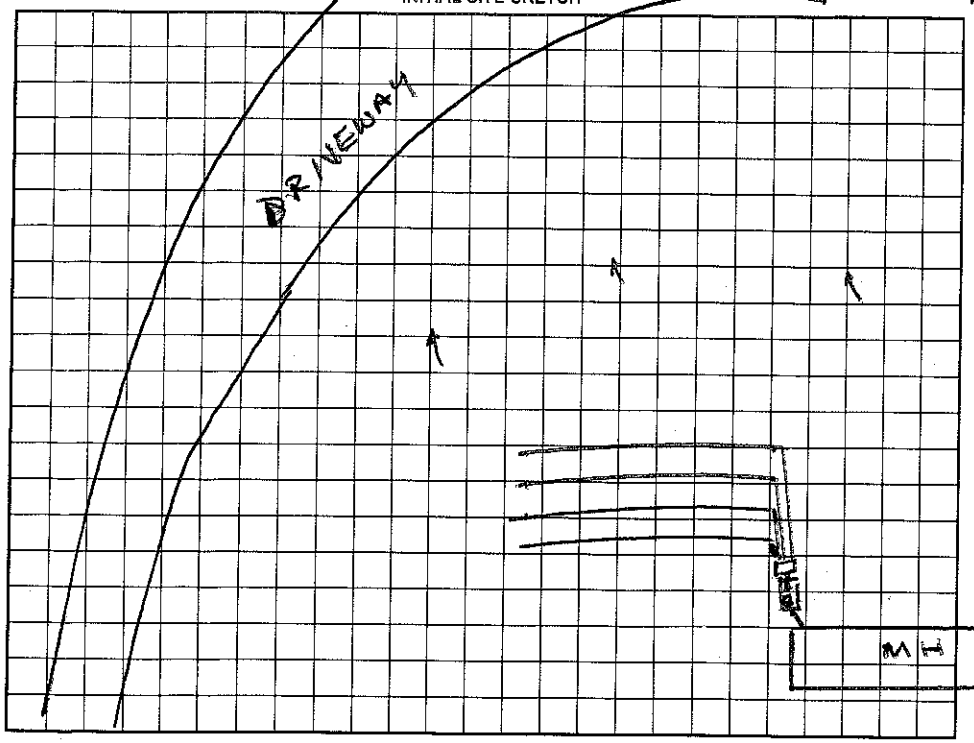

Comments:/Conditions:

60' WELL

AS BUILT SKETCH

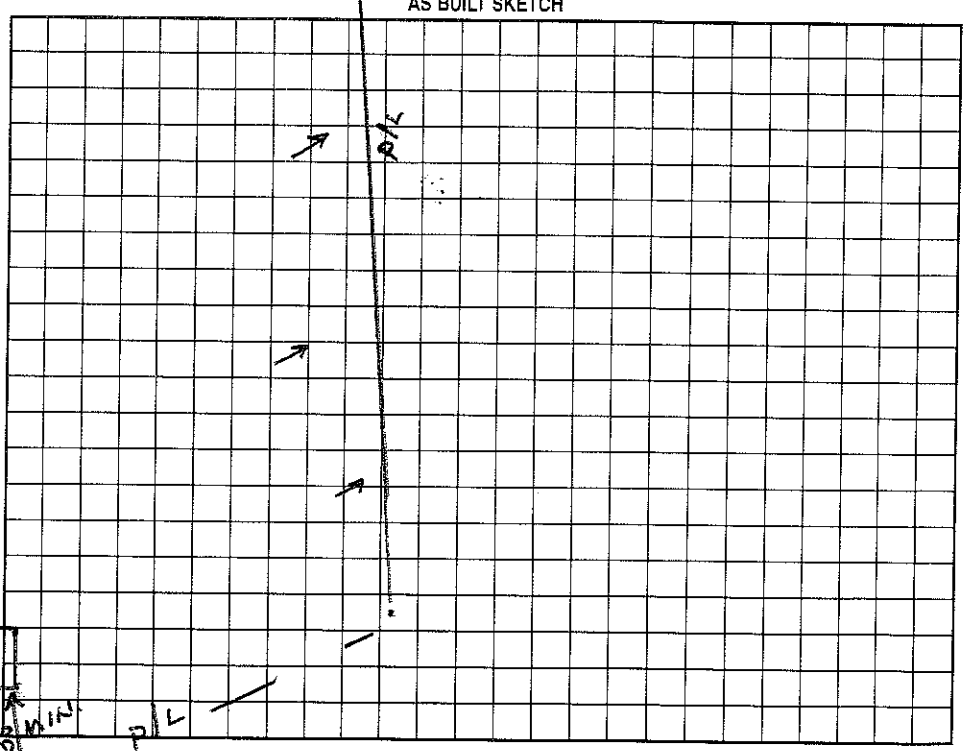

Permit can be suspended or revoked if any false information is supplied toward securing the permit/any unauthorized changes are made to the site/any unauthorized changes are made in the installation of the system. Improvement Permit with plat valid without expiration. Improvement Permit with site plan valid for sixty months. Authorization to Construct is valid for a period equal to that of Improvement Permit – not to exceed sixty months.

Signed: X Elston Hedges date 1/20/00

Improvement Permit by: Wesley Sparks RS. date 1/19/00

Authorization to Construct by: Wesley Sparks RS. date 1/19/00

Installed by: LEVON BENTSON

Operation Permit by: C. Myers RS date 7/25/00

Existing System Inspection by: date

HEALTH DEPT. COPY: WHITE OWNER COPY (FINAL): YELLOW OWNER COPY (INITIAL): PINK