IREDELL COUNTY HEALTH DEPARTMENT

STATESVILLE 704-878-5305 MOORESVILLE 704-664-5281

IMPROVEMENT PERMIT / AUTHORIZATION TO CONSTRUCT / OPERATION PERMIT / EXISTING SYSTEM INSPECTION

PERMIT# 078274 PIN# ~~4659 60 7336~~ 4659 60 0218 DATE 12/17/98

OWNER OR CONTRACTOR Bobby P. Brawley Elston Hodges PHONE: Business _____ Home 664-5153

ADDRESS 985 Hampton Place Mooresville, NC. 28115

LOCATION 115-21N TL just before Shepherd School on new road ~ 650 feet to property below ball field

SUBDIVISION _____ BLOCK / SECTION _____ LOT _____ LOT AREA 10.3 Ac SITE CLASS. PS DESIGN FLOW 360 L.T.A.R. .3

Septic Tank: 1000 Gallons; STB _____ Date _____

Pump Tank: 1000 Gallons; PT _____ Date _____

Pump Make: _____ Model _____ Serial No. _____

Nitrification Field: No Fields 1 Square Feet 900 X Linear Feet 300 X

No Lines 4 Trench Width 36" Max Trench Bottom Depth 36" Gravel Depth SAND

X New System ☐ Repair System Type: I, II, III, IV, V, VI

System Description: Pres Man — Chamber or HDS

Repair System Description: Same

Maintenance Agreement Required: ☐ Yes X No

X House/Mod. Home No. Bedrooms 3

☐ Mobile Home No. Bathrooms 2

☐ Business No. Employees _____

☐ Other _____


☐ Slab ☐ Crawl Space X Basement w/plumbing ☐ Basement wo/plumbing

Water Supply: X Individual ☐ Public ☐ Community

Comments:/Conditions:


390' (1"=40')

INITIAL SITE SKETCH

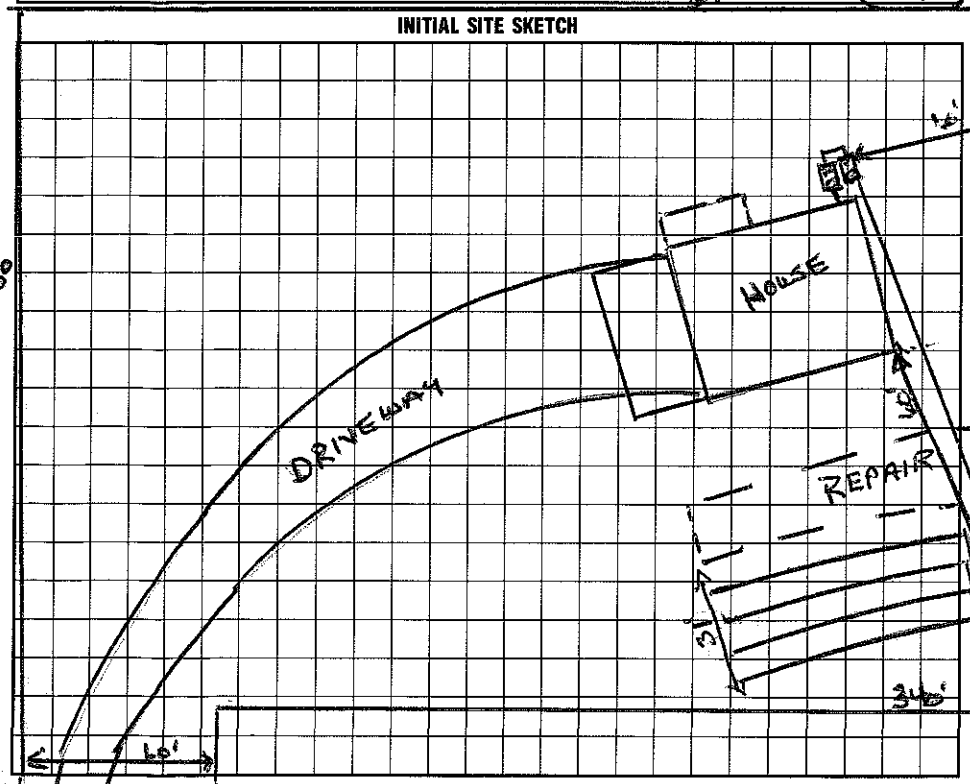

Comments:/Conditions:

AS BUILT SKETCH

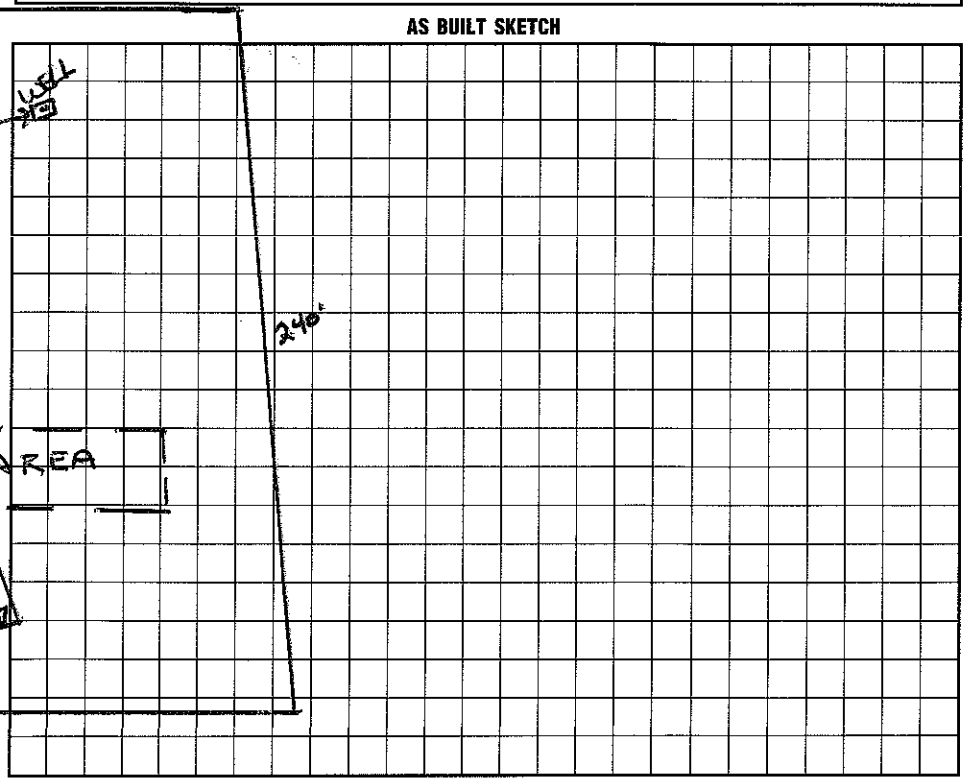

I understand that this permit can be suspended or revoked if any false information is supplied toward securing the permit/any unauthorized changes are made to the site/any unauthorized changes are made in the installation of the system. Improvement Permit with plat valid without expiration. Improvement Permit with site plan valid for sixty months. Authorization to Construct is valid for a period equal to that of Improvement Permit – not to exceed sixty months.

Signed: Bobby P. Brawley P.O.A. *Har Maggie S. Brawley date 12-18-98

Improvement Permit by: Wesley Sparks RS date 3/31/99

Authorization to Construct by: Wesley Sparks RS. date 12/19/98

Installed by: Larry Bryan

Operation Permit by: Wesley Sparks RS date 11/28/01

Existing System Inspection by: _____ date _____

HEALTH DEPT. COPY: WHITE INSPECTION COPY (FINAL): GREEN OWNER COPY (FINAL): YELLOW INSPECTION COPY (INITIAL): PINK OWNER COPY (INITIAL): GOLD