IREDELL COUNTY HEALTH DEPARTMENT

STATESVILLE 704-878-5305 MOORESVILLE 704-664-5281

IMPROVEMENT PERMIT / AUTHORIZATION TO CONSTRUCT / OPERATION PERMIT / EXISTING SYSTEM INSPECTION

PERMIT# 078274 PIN# 4659 60 4336

OWNER OR CONTRACTOR Bobby P. Brawley Elston Hodges PHONE: Business DATE 12/17/98

ADDRESS 985 Hampton Place Mooresville, NC. 28115 Home 664-5153

LOCATION 115-21N TL just before Shepherd School on new road ~ 650 feet to property below well field

SUBDIVISION BLOCK / SECTION LOT LOT AREA 10.3 Ac SITE CLASS. PS DESIGN FLOW 360 L.T.A.R. .3

Septic Tank: 1000 Gallons; STB Date

Pump Tank: 1000 Gallons; PT Date

Pump Make: Model Serial No.

Nitrification Field: No Fields 1 Square Feet 900* Linear Feet 300*

No Lines 4 Trench Width 36" Max Trench Bottom Depth 36" Gravel Depth SAND

☒ New System ☐ Repair System Type: I, II, III, IV, V, VI

System Description: Pres Man — Ch Plastic or H05

Repair System Description: Some

Maintenance Agreement Required: ☐ Yes ☒ No

☒ House/Mod. Home ☐ Mobile Home ☐ Business ☐ Other

No. Bedrooms 3 No. Bathrooms 2 No. Employees


☐ Slab ☐ Crawl Space ☒ Basement w/plumbing ☐ Basement wo/plumbing

Water Supply: ☒ Individual ☐ Public ☐ Community


Comments:/Conditions:

Comments:/Conditions:

INITIAL SITE SKETCH

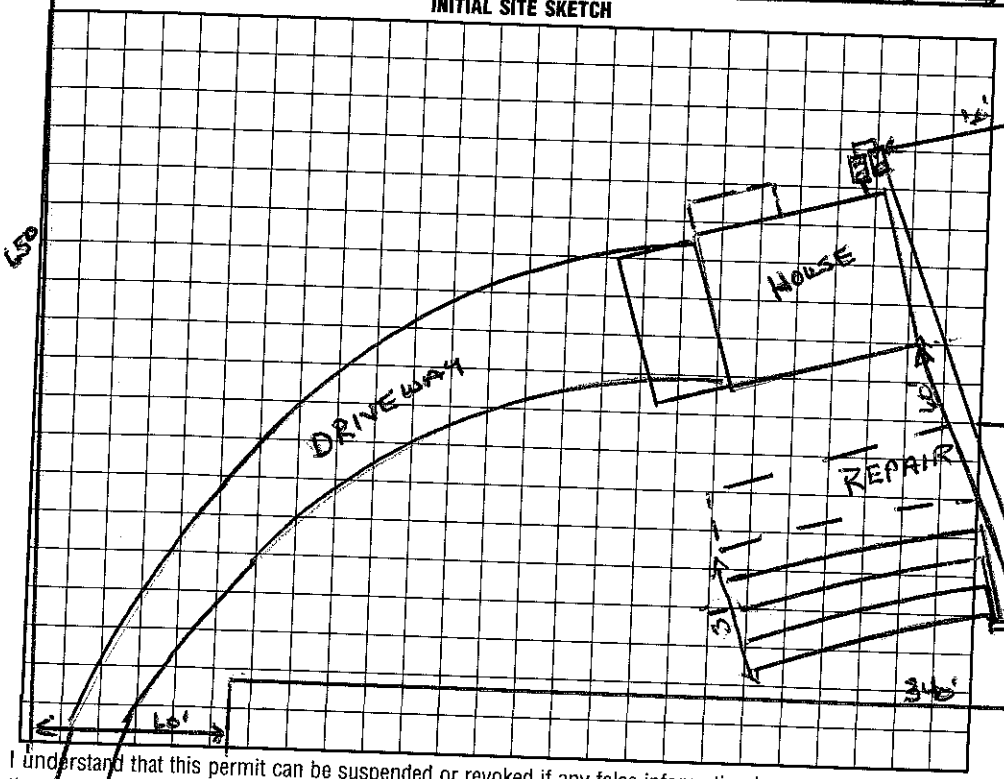

AS BUILT SKETCH

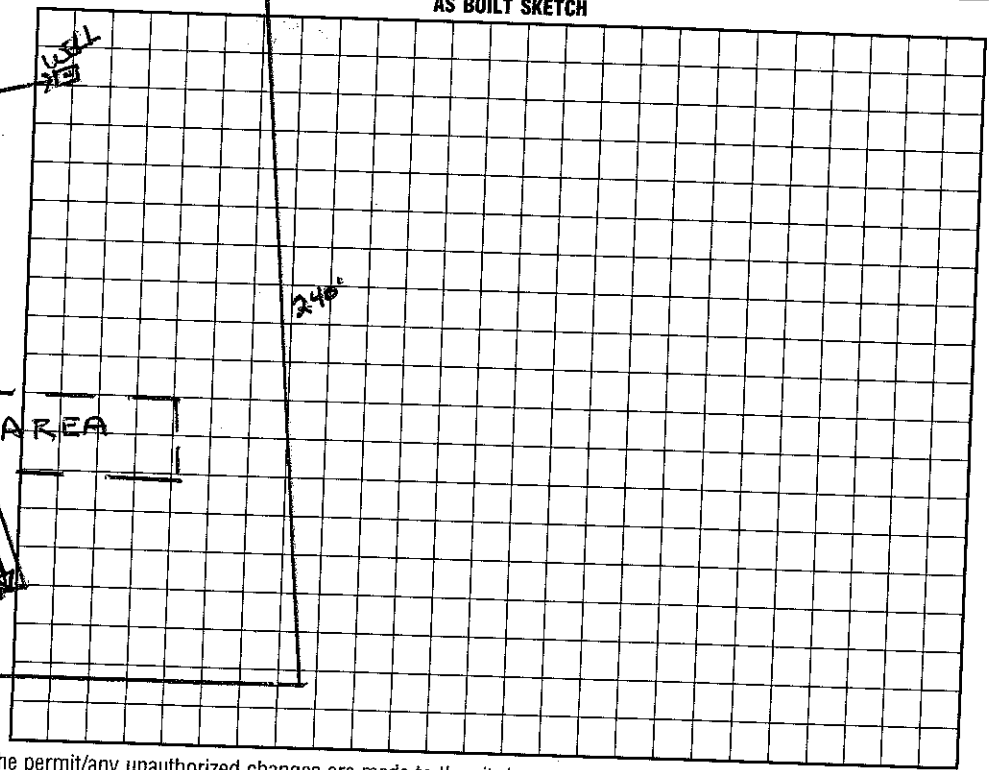

I understand that this permit can be suspended or revoked if any false information is supplied toward securing the permit/any unauthorized changes are made to the site/any unauthorized changes are made in the installation of the system. Improvement Permit with plat valid without expiration. Improvement Permit with site plan valid for sixty months. Authorization to Construct is valid for a period equal to that of Improvement Permit – not to exceed sixty months.

Signed: Bobby P. Brawley P.O.A. *by Maggie S. Brawley

Improvement Permit by: Wesley Sparks RS. date 12-18-98

Authorization to Construct by: Wesley Sparks RS. date 3/31/99

Installed by: Larry Bryan

Operation Permit by: Wesley Sparks RS. date 12/17/98

Existing System Inspection by: date 11/28/01

HEALTH DEPT. COPY: WHITE INSPECTION COPY (FINAL): GREEN OWNER COPY (FINAL): YELLOW INSPECTION COPY (INITIAL): PINK OWNER COPY (INITIAL): GOLD