IREDELL COUNTY HEALTH DEPARTMENT

STATESVILLE 704-878-5305 MOORESVILLE 704-664-5281

IMPROVEMENT PERMIT / AUTHORIZATION TO CONSTRUCT / OPERATION PERMIT / EXISTING SYSTEM INSPECTION

PERMIT# 078274 PIN# 4659 60 4336 4669600218 DATE 9/6/01

OWNER OR CONTRACTOR Elston Hedges PHONE: Business Home

ADDRESS 985 Hampton Place Mooresville, NC. 28115 132 Hedges Ln

LOCATION 115-21N TL just before Shepherd School on new road. ~ 450 ft back to Prop. below bottom lot

SUBDIVISION N/A BLOCK / SECTION LOT LOT AREA 10.3 SITE CLASS. PS DESIGN FLOW 360 L.T.A.R. .3

Septic Tank: 1000 Gallons; STB 794 Date 3/3/00

Pump Tank: 1000 Gallons; PT 283 Date 1/9/01

Pump Make: ZOELLER Model N-152A Serial No. —

Nitrification Field: No Fields V1 Square Feet 900 Linear Feet 300 ✱

No Lines 4 Trench Width 3' Max Trench Bottom Depth 36" Gravel Depth SAND.

☒ New System ☐ Repair System Type: I, II, III, IV, V, VI

System Description: Pump to Existing CH. Pres.

Repair System Description:

Maintenance Agreement Required: ☐ Yes ☒ No

☒ House/Mod. Home No. Bedrooms 3

☐ Mobile Home No. Bathrooms 3

☐ Business No. Employees

☐ Other

☐ Slab ☐ Crawl Space ☒ Basement w/plumbing ☐ Basement wo/plumbing


Water Supply: ☒ Individual ☐ Public ☐ Community

Comments:/Conditions:

Comments:/Conditions:

INITIAL SITE SKETCH

AS BUILT SKETCH

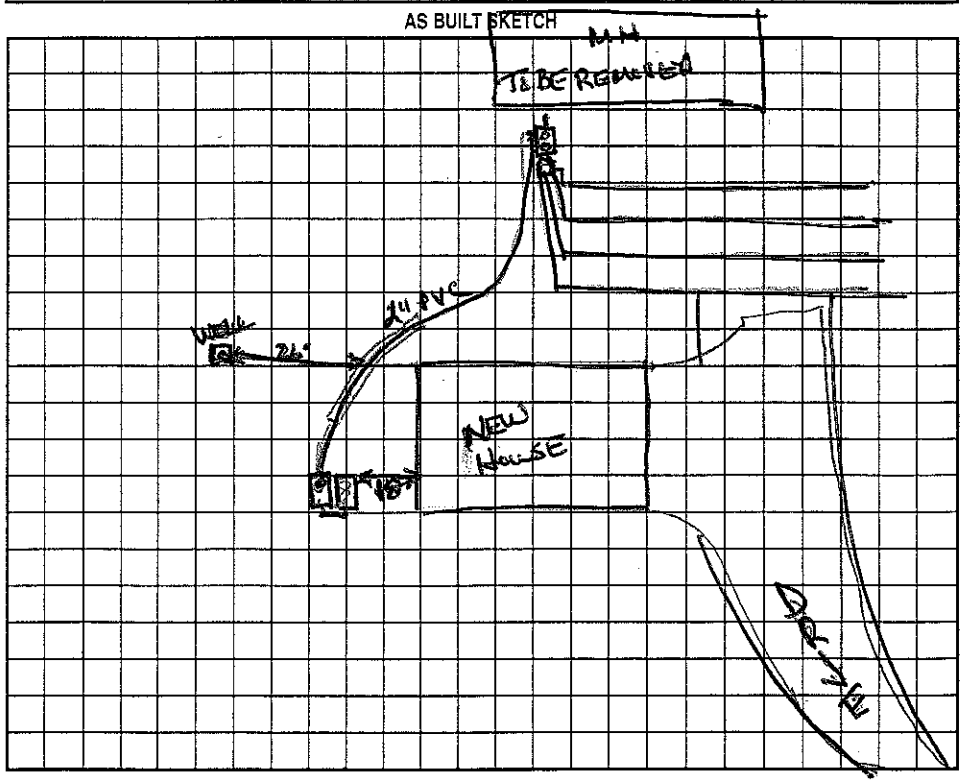

Permit can be suspended or revoked if any false information is supplied toward securing the permit/any unauthorized changes are made to the site/any unauthorized changes are made in the installation of the system. Improvement Permit with plat valid without expiration. Improvement Permit with site plan valid for sixty months. Authorization to Construct is valid for a period equal to that of Improvement Permit – not to exceed sixty months.

Signed: date

Improvement Permit by: date

Authorization to Construct by: date

Installed by: Larry Beam

Operation Permit by: Wesley Sparks RS. date 11/28/01

Existing System Inspection by: date

HEALTH DEPT. COPY: WHITE OWNER COPY (FINAL): YELLOW OWNER COPY (INITIAL): PINK