IREDELL COUNTY HEALTH DEPARTMENT

STATESVILLE 704-878-5305 MOORESVILLE 704-664-5281

100.00 19.0

IMPROVEMENT PERMIT / AUTHORIZATION TO CONSTRUCT / OPERATION PERMIT / EXISTING SYSTEM INSPECTION

PERMIT# 132313 PIN# 4659-60-4361 DATE

OWNER OR APPLICANT James W. Hedges PHONE: Business Home

ADDRESS 305 S. Eglet St. Seabrook FL 33872

LOCATION 115, TL across from Shepard Rd on Lt

SUBDIVISION BLOCK / SECTION LOT LOT AREA 4.405 AC SITE CLASS. PS DESIGN FLOW 360 L.T.A.R. 0.3

Septic Tank: 1000 Gallons; STB 825 Date

Pump Tank: Gallons; PT Date

Pump Make: Model Serial No.

Nitrification Field: No Fields 1 Square Feet 1200 Linear Feet 400

No Lines 3 or 4 Trench Width 36" Max Trench Bottom Depth 36" Gravel Depth 12"

☒ New System ☐ Repair ☐ Expansion System Type: I II III IV V VI

System Description: Gravity Conventional

Repair System Description: Same

Maintenance Agreement Required: ☐ Yes ☒ No

☒ House/Mod. Home ☐ Mobile Home ☐ Business ☐ Other

No. Bedrooms 3 No. Persons No. Employees

Water Supply: ☒ Individual ☐ Public ☐ Community


☐ Gravity ☐ Pressure ☐ Slab ☐ Crawl Space ☒ Basement w/plumbing ☐ Basement wo/plumbing

Comments/Conditions:

Comments/Conditions:

Blue tuf-tite filter

INITIAL SITE SKETCH

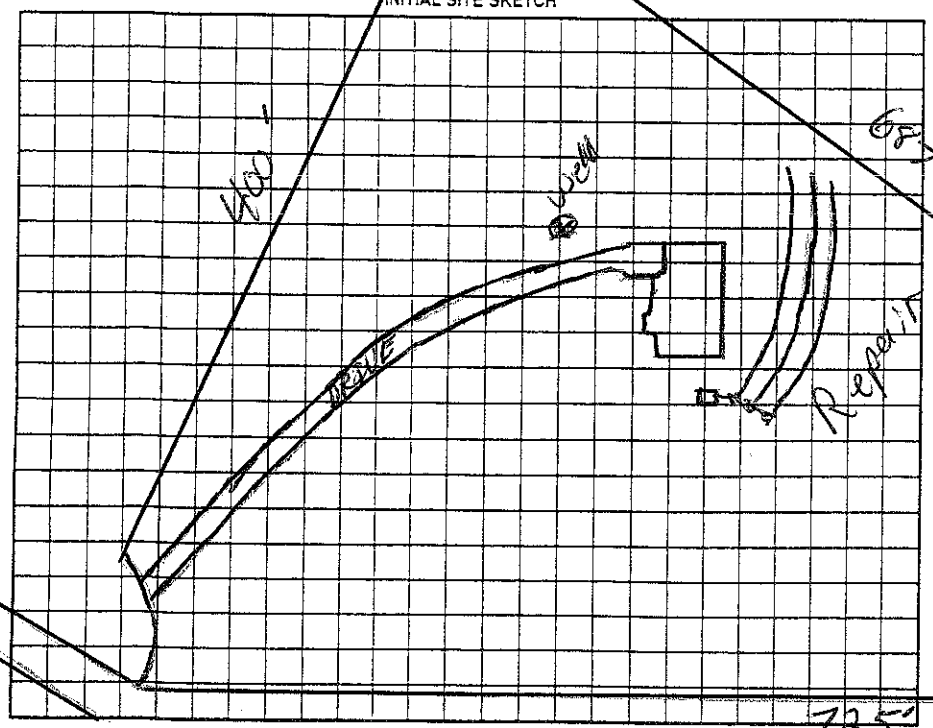

AS BUILT SKETCH

Installed Quick 4 Infiltrator 3@100' as per initial site sketch except tank & lines below house not to the side

well not in at time of inspection

Permit can be suspended or revoked if any false information is supplied toward securing the permit/any unauthorized changes are made to the site/any unauthorized changes are made in the installation of the system. Improvement Permit with plat valid without expiration ☐ Improvement Permit with site plan valid for sixty months ☒ Authorization to Construct is valid for a period equal to that of Improvement Permit – not to exceed sixty months.

Signed: James W Hedges date 11/10/05 Installed by: Rowan Septic

Improvement Permit by: RS date 11/8/05 Operation Permit by: Cindy Mahaffey date 12-7-06

Authorization to Construct by: RS date 11/8/05 Existing System Inspection by: date

HEALTH DEPT. COPY: WHITE OWNER COPY (FINAL): YELLOW OWNER COPY (INITIAL): PINK