IREDELL COUNTY HEALTH DEPARTMENT

STATESVILLE 704-878-5305 MOORESVILLE 704-664-5281

IMPROVEMENT PERMIT / AUTHORIZATION TO CONSTRUCT / OPERATION PERMIT / EXISTING SYSTEM INSPECTION

PERMIT# 132846 PIN# 4659 61 2835 600 DATE 3/7/06

OWNER OR APPLICANT George Church Const. PHONE: Business Home 704-664 2845

ADDRESS 123 Sardaroni Lp. Mooresville, NC 28117

LOCATION 115 N TR Sardaroni Lp. to 3RD house on R

SUBDIVISION No BLOCK / SECTION LOT No LOT AREA .76Ac SITE CLASS. P DESIGN FLOW 360 L.T.A.R.

Septic Tank: 1000 Gallons: STB 794 Date 2/12/06
Pump Tank: Gallons: PT Date
Pump Make: Model Serial No.
Nitrification Field: No Fields Square Feet EXISTING Linear Feet
No Lines Trench Width Max Trench Bottom Depth Gravel Depth

☐ New System ☐ Repair ☒ Expansion System Type: I (II) III IV V VI
System Description:
Repair System Description: Add New Tank
Maintenance Agreement Required: ☐ Yes ☒ No

☒ House/Mod. Home No. Bedrooms 3
☐ Mobile Home No. Persons 2
☐ Business No. Employees
☐ Other


Water Supply: ☒ Individual ☐ Public ☐ Community NEW

☐ Gravity ☐ Pressure ☐ Slab ☒ Crawl Space ☐ Basement w/plumbing ☐ Basement wo/plumbing


Comments:/Conditions: Add NEW SEPTIC TANK W/ FILTER IN LOCATION SHOWN HERE.

Comments:/Conditions:

INITIAL SITE SKETCH

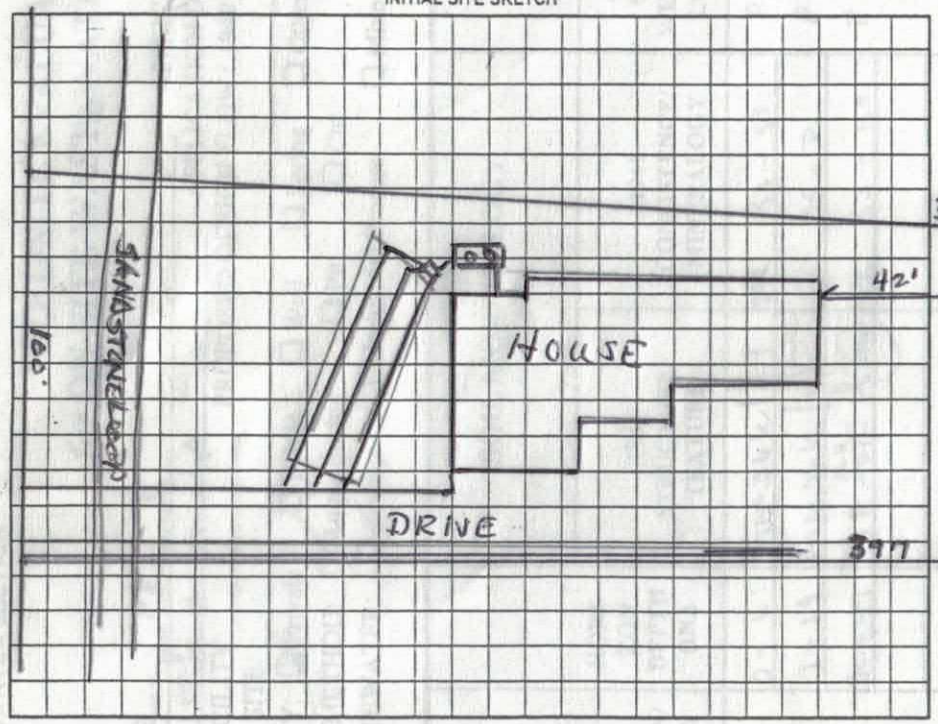

AS BUILT SKETCH

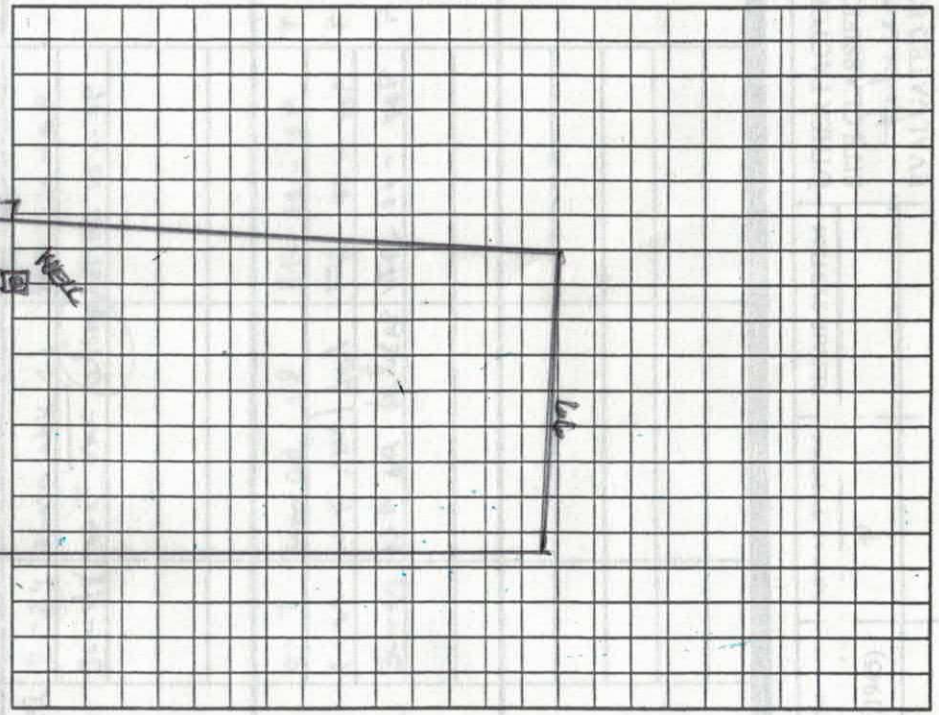

Permit can be suspended or revoked if any false information is supplied toward securing the permit/any unauthorized changes are made to the site/any unauthorized changes are made in the installation of the system. Improvement Permit with plat valid without expiration ☐ Improvement Permit with site plan valid for sixty months ☐ Authorization to Construct is valid for a period equal to that of Improvement Permit – not to exceed sixty months.

Signed: George Church date 3-10-06 Installed by: George Church

Improvement Permit by: Wesley Sparks RS. date 3/7/06 Operation Permit by: Wesley Sparks RS. date 3/20/06

Authorization to Construct by: Wesley Sparks RS. date 3/7/06 Existing System Inspection by: date

HEALTH DEPT. COPY: WHITE OWNER COPY (FINAL): YELLOW OWNER COPY (INITIAL): PINK