IREDELL COUNTY HEALTH DEPARTMENT

STATESVILLE 704-878-5305 MOORESVILLE 704-664-5281

4659612835

IMPROVEMENT PERMIT / CERTIFICATE OF COMPLETION / OPERATION PERMIT / EXISTING SYSTEM INSPECTION

PROPERTY DESCRIPTION NO. REPAIR DATE 9/3/93 TAX MAP NO. REPAIR

OWNER OR CONTRACTOR HALBERT HORNE PHONE: Business Home

ADDRESS R+S Box 683 MOORESVILLE, NC

LOCATION 115N - TR FIRST GRAVEL PAST SHEPARD SCHOOL (L) TO 3RD HOUSE ON (R)

SUBDIVISION BLOCK / SECTION LOT LOT AREA SITE CLASS. L.T.A.R.

Water Supply: ☑ Individual ☐ Community ☐ Public 2"

Septic Tank: EXISTING Gallons; STB Date

Pump Tank: Gallons; PT Date

Nitrification Field: No Fields 1 Square Feet 720 Linear Feet 240

No Lines Trench Width Trench Depth Gravel Depth

~~☐~~ New System ☒ Repair System Type: I, II, III, IV, V, VI

System Description: CONV.

Repair System Description:

Maintenance Agreement Required: ☐ Yes ☐ No

☐ House/Mod. Home No. Bedrooms

☐ Mobile Home No. Bathrooms

☐ Business No. Employees

☐ Other

☐ Slab ☐ Crawl Space ☐ Basement w/plumbing ☐ Basement wo/plumbing

Garbage Disposal: ☐ Yes ☐ No


Auto. Dishwasher: ☐ Yes ☐ No

Auto. Washing Machine: ☐ Yes ☐ No

Other

Comments: (1) CHECK SANITARY T IN TANK; (2) SET NEW D/BOX AND BEGIN DRAINFIELD AS SHOWN HERE (3) TRENCHES NO DEEPER THAN 30" TO TRENCH BOTTOM

INITIAL SITE SKETCH

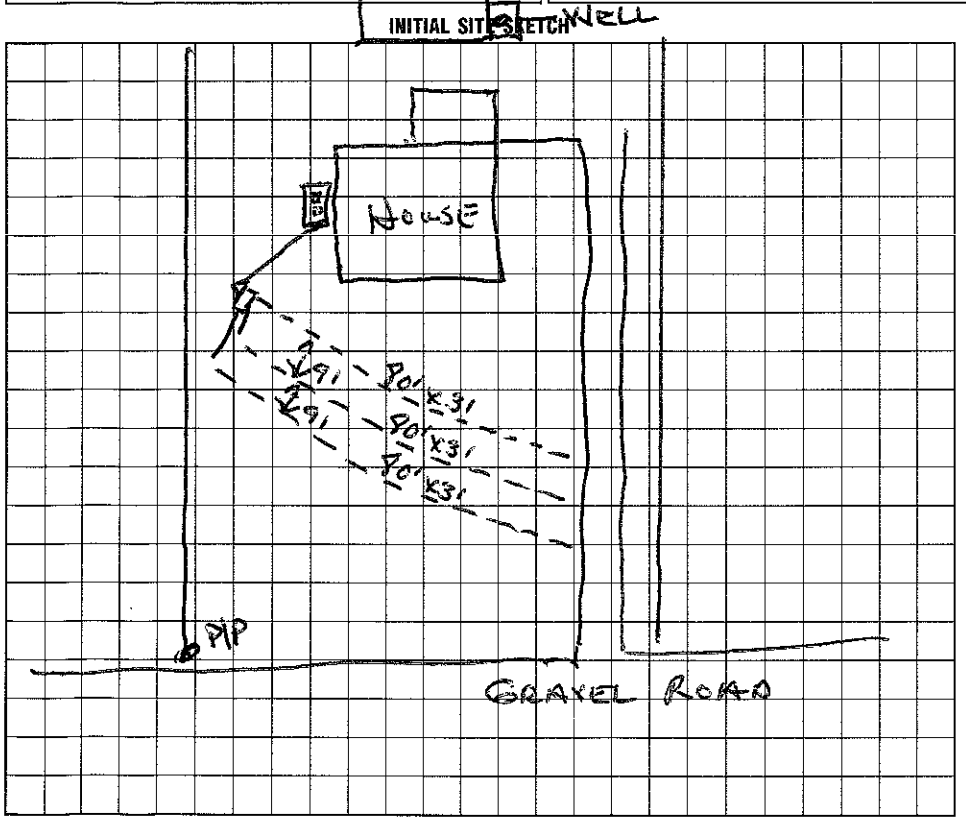

AS BUILT SKETCH

SANITARY T REPLACED
DRAIN FIELD INSTALLED AS DRAWN AEWS

I understand that this permit can be suspended or revoked if any false information is supplied toward securing the permit/any unauthorized changes are made to the site/any unauthorized changes are made in the installation of the system. Improvement Permit is valid for 60 months from date of issuance.

Signed:

Improvement Permit by: Wesley Sparks R.S. date 9/3/93

Existing System Inspection by: date

Installed by: J. BOWLES

Certificate of Completion by: Wesley Sparks R.S. date 10/22/93

Operation Permit by: date

HEALTH DEPT. COPY: WHITE INSPECTION COPY (FINAL): GREEN OWNER COPY (FINAL): YELLOW INSPECTION COPY (INITIAL): PINK OWNER COPY (INITIAL): GOLD