IREDELL COUNTY HEALTH DEPARTMENT

STATESVILLE 704-878-5305 MOORESVILLE 704-664-5281

IMPROVEMENT PERMIT / AUTHORIZATION TO CONSTRUCT / OPERATION PERMIT / EXISTING SYSTEM INSPECTION

PERMIT# 086669 PIN# 4659645698 PT DATE 3/8/00

OWNER OR CONTRACTOR Robert McDaniel PHONE: Business Home (828) 648-5656

ADDRESS 621 N. Canton Rd Canton, NC 28716

LOCATION Hwy 115 S, TL Shepards Rd, TL Staff Ln. at end / 191 STAFF LN

SUBDIVISION Shepherds Field BLOCK / SECTION LOT 10 LOT AREA .5 SITE CLASS. PS DESIGN FLOW 360 L.T.A.R. .3

Septic Tank: 1000 Gallons; STB 1012 Date 7/02
Pump Tank: 1000 Gallons; PT 1012 Date 7/02
Pump Make: Model Serial No.
Nitrification Field: No Fields 1 Square Feet 900 Linear Feet 300
No Lines 4 Trench Width 36" Max Trench Bottom Depth 36" Gravel Depth —

☒ New System ☐ Repair System Type: I, II, III, IV, V, VI
System Description: PM Chamber 25% Reduc
Repair System Description: PM Panel 50% Reduc
Maintenance Agreement Required: ☐ Yes ☒ No

☐ House/Mod. Home No. Bedrooms 3
☒ Mobile Home No. Bathrooms 2
☐ Business No. Employees
☐ Other
☐ Slab ☒ Crawl Space ☐ Basement w/plumbing ☐ Basement wo/plumbing


Water Supply: ☒ Individual ☐ Public ☐ Community

Comments:/Conditions: Neighboring Well at least 100' from Drain Field

1=60 scale

Comments:/Conditions: INFILTRATOR INSTALLED

INITIAL SITE SKETCH

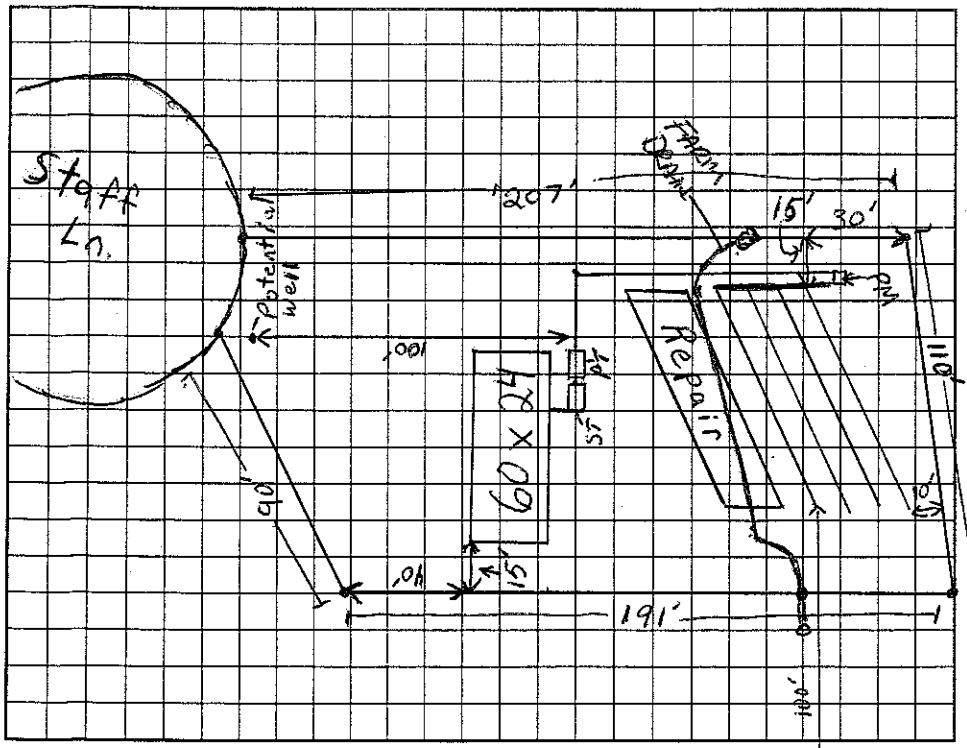

AS BUILT SKETCH

Permit can be suspended or revoked if any false information is supplied toward securing the permit/any unauthorized changes are made to the site/any unauthorized changes are made in the installation of the system. Improvement Permit with plat valid without expiration. Improvement Permit with site plan valid for sixty months. Authorization to Construct is valid for a period equal to that of Improvement Permit – not to exceed sixty months.

Signed: Joan McDaniel date 3-15-00 Installed by: Craig Thompson

Improvement Permit by: Wesley Sparks RS. date 3/8/00 Operation Permit by: Wesley Sparks RS date 6/4/03

Authorization to Construct by: Wesley Sparks RS date 3/8/00 Existing System Inspection by: date

HEALTH DEPT. COPY: WHITE OWNER COPY (FINAL): YELLOW OWNER COPY (INITIAL): PINK