4659645819

IREDELL COUNTY HEALTH DEPARTMENT

STATESVILLE 704-878-5305 MOORESVILLE 704-664-5281

IMPROVEMENT PERMIT / CERTIFICATE OF COMPLETION / OPERATION PERMIT / EXISTING SYSTEM INSPECTION

PROPERTY DESCRIPTION NO. 19865 DATE 12/8/94 TAX MAP NO. 4D-1-A-11 Watershed: ☐ Yes ☐ No

OWNER OR CONTRACTOR Cathy McDaniel PHONE: Business Home 664-4848

ADDRESS 913 Ferncliff Dr. Mooresville, NC. 28115

LOCATION Shepard Rd. TL into Shepardsfield to end of road on (R)

SUBDIVISION Shepards Field BLOCK / SECTION LOT 11 LOT AREA ~3ac. SITE CLASS. P DESIGN FLOW 240 L.T.A.R. .35

Septic Tank: 1000 Gallons; STB 1012 Date 9/26/94

Pump Tank: Gallons; PT Date

Pump Make: Model Serial No.

Nitrification Field: No Fields 1 Square Feet 685 Linear Feet 228

No Lines 3 Trench Width 36" Max Trench Bottom Depth 36" Gravel Depth 12"

☑ New System ☐ Repair System Type: I (II) III, IV, V, VI

System Description: CONV-DIST BOX

Repair System Description: SAME

Maintenance Agreement Required: ☐ Yes ☑ No

☑ House/Mod. Home No. Bedrooms 2

☐ Mobile Home No. Bathrooms 2

☐ Business No. Employees

☐ Other


☐ Slab ☑ Crawl Space ☐ Basement w/plumbing ☐ Basement wo/plumbing

Water Supply: ☑ Individual ☐ Community ☐ Public

Comments: Trench depth no more than 36" to trench bottom.

Comments: Installed Jan 1995

INITIAL SITE SKETCH

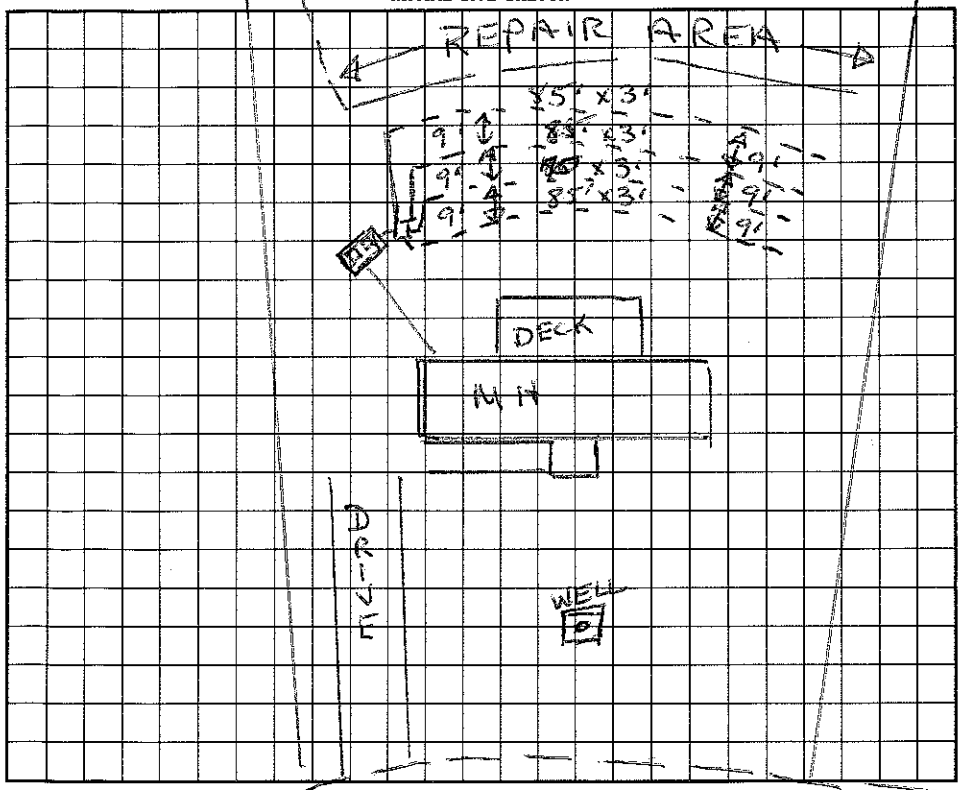

AS BUILT SKETCH

I understand that this permit can be suspended or revoked if any false information is supplied toward securing the permit/any unauthorized changes are made to the site/any unauthorized changes are made in the installation of the system. Improvement Permit is valid for 60 months from date of issuance.

Signed: X Darrell Sparks

Improvement Permit by: W. Darrell Sparks RS. date 12/8/94

Existing System Inspection by: date

Installed by: Donald Lackey

Certificate of Completion by: Wesley Sparks RS date 1/3/95

Operation Permit by: date

HEALTH DEPT. COPY: WHITE INSPECTION COPY (FINAL): GREEN OWNER COPY (FINAL): YELLOW INSPECTION COPY (INITIAL): PINK OWNER COPY (INITIAL): GOLD