IREDELL COUNTY HEALTH DEPARTMENT

4659657609

STATESVILLE 704-878-5305 MOORESVILLE 704-664-5281

IMPROVEMENT PERMIT / CERTIFICATE OF COMPLETION / OPERATION PERMIT / EXISTING SYSTEM INSPECTION

PROPERTY DESCRIPTION NO. 17931 DATE 3/8/94 TAX MAP NO. 4D-1-A-16 Watershed: ☐ Yes ☒ No

OWNER OR CONTRACTOR Jerry L. Davis PHONE: Business _____ Home 664-1531

ADDRESS Rt 4 Box 466 Mooresville, NC. 28115

LOCATION Shepard Rd. Tr on Shepardfield to Lot 16 on (R)

SUBDIVISION Shepardfield BLOCK / SECTION _____ LOT 16 LOT AREA 1.29 SITE CLASS. P. DESIGN FLOW .3240 L.T.A.R. .3

Septic Tank: 1000 Gallons; STB 794 Date 11/28/94

Pump Tank: _____ Gallons; PT _____ Date _____

Pump Make: _____ Model _____ Serial No. _____

Nitrification Field: No Fields 1 Square Feet 800 Linear Feet 266

No Lines 3 Trench Width 3' Max Trench Bottom Depth 36" Gravel Depth _____

☒ New System ☐ Repair System Type: I (II) III, IV, V, VI

System Description: DIST. BOX - CONV.

Repair System Description: _____

Maintenance Agreement Required: ☐ Yes ☒ No

☐ House/Mod. Home No. Bedrooms 2

☒ Mobile Home No. Bathrooms 2

☐ Business No. Employees ____

☐ Other _____


☐ Slab ☒ Crawl Space ☐ Basement w/plumbing ☐ Basement wo/plumbing

Water Supply: ☒ Individual ☐ Community ☐ Public PROPOSED

Comments: Some trees need to be cleared at end of drainlines. MAXIMUM TRENCH DEPTH 36"

Comments:

INITIAL SITE SKETCH

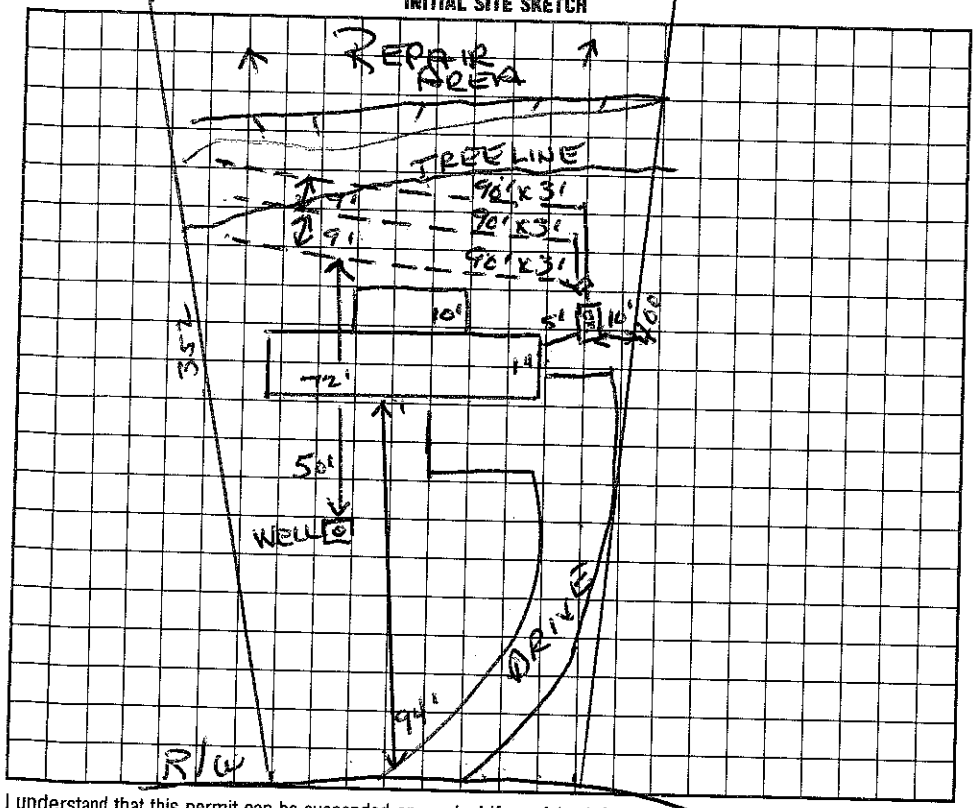

AS BUILT SKETCH

I understand that this permit can be suspended or revoked if any false information is supplied toward securing the permit/any unauthorized changes are made to the site/any unauthorized changes are made in the installation of the system. Improvement Permit is valid for 60 months from date of issuance.

Signed: Jerry L Davis

Improvement Permit by: Wesley Sparks RS. date 3/8/94

Existing System Inspection by: _____ date _____

Installed by: F J Ervin

Certificate of Completion by: Wesley Sparks RS. date 6/6/94

Operation Permit by: _____ date _____

HEALTH DEPT. COPY: WHITE INSPECTION COPY (FINAL): GREEN OWNER COPY (FINAL): YELLOW INSPECTION COPY (INITIAL): PINK OWNER COPY (INITIAL): GOLD