IREDELL COUNTY HEALTH DEPARTMENT

4659658708 STATESVILLE 704-878-5305

4659659850 MOORESVILLE 704-664-5281

IMPROVEMENT PERMIT / CERTIFICATE OF COMPLETION / OPERATION PERMIT / EXISTING SYSTEM INSPECTION

PROPERTY DESCRIPTION NO. 16397 DATE August 12, '93

OWNER OR CONTRACTOR Alex Ogden TAX MAP NO. 401A [7/18

ADDRESS PHONE: Business Home

LOCATION 115-21 N to Shepherd Rd ~ 1/2 - 3/4 mile TL gravel rd. on right

SUBDIVISION Shepherds Fold BLOCK / SECTION LOT 17/18 LOT AREA SITE CLASS. L.T.A.R.

Water Supply: ☑ Individual ☐ Community ☐ Public

Septic Tank: 1000 Gallons; STB ACP 782 Date 6-18-93

Pump Tank: Gallons; PT Date

Nitrification Field: No Fields 1 Square Feet 1200 Linear Feet 400

No Lines 4 Trench Width 36" Trench Depth ~36" Gravel Depth 12"

☑ New System ☐ Repair System Type: I, II, III, IV, V, VI

System Description: gravity conventional

Repair System Description: SAME

Maintenance Agreement Required: ☐ Yes ☑ No

☐ House/Mod. Home ☑ Mobile Home ☐ Business ☐ Other

No. Bedrooms 3 No. Bathrooms 2 No. Employees

☐ Slab ☑ Crawl Space ☐ Basement w/plumbing ☐ Basement wo/plumbing

Garbage Disposal: ☐ Yes ☑ No


Auto. Dishwasher: ☑ Yes ☐ No

Auto. Washing Machine: ☑ Yes ☐ No

Other

Comments: Well not installed and mobile home not on site as of 8/12/93

INITIAL SITE SKETCH

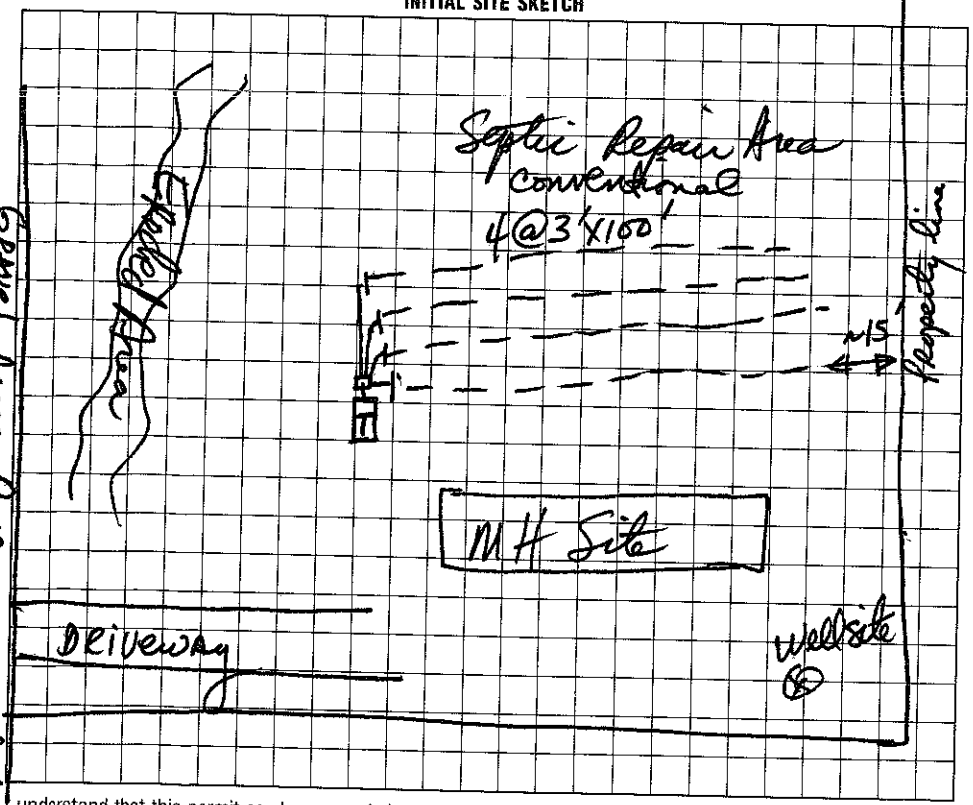

AS BUILT SKETCH

I understand that this permit can be suspended or revoked if any false information is supplied toward securing the permit/any unauthorized changes are made to the site/any unauthorized changes are made in the installation of the system. Improvement Permit is valid for 60 months from date of issuance.

Signed:

Improvement Permit by: AWS date

Existing System Inspection by: date

Installed by: J J Enterprises

Certificate of Completion by: David R Hunsucker LRS date 8/12/93

Operation Permit by: date

HEALTH DEPT. COPY: WHITE INSPECTION COPY (FINAL): GREEN OWNER COPY (FINAL): YELLOW INSPECTION COPY (INITIAL): PINK OWNER COPY (INITIAL): GOLD