IREDELL COUNTY HEALTH DEPARTMENT

STATESVILLE 704-878-5305 MOORESVILLE 704-664-5281

IMPROVEMENT PERMIT / AUTHORIZATION TO CONSTRUCT / OPERATION PERMIT / EXISTING SYSTEM INSPECTION

PERMIT# 138992 PIN# 4659666974 #4659666947 DATE 12-22-06

OWNER OR APPLICANT Shepherds Bluff LLC (Billy Allen) PHONE: Business _____ Home _____

ADDRESS 111-B Raceway Dr Mooresville 28115

LOCATION Hwy 115/21 N RT Shepherds Rd, Lt on Shepherds Bluff Dr, Lot on Right

SUBDIVISION Shepherds Bluff BLOCK / SECTION _____ LOT 14 LOT AREA .474 Acre SITE CLASS. P.S. DESIGN FLOW 360 L.T.A.R. .275 gpd/ft2

Septic Tank: 1000 Gallons; STB 1017 Date 3/1/07

Pump Tank: 1000 Gallons; PT 17 Date 5/18/07

Pump Make: Cowles Model [illegible] Serial No. 4167

Nitrification Field: No Fields 1 Square Feet 984 Linear Feet 328

No Lines 4@82' Trench Width 36" Max Trench Bottom Depth 18"

☒ New System ☐ Repair ☐ Expansion System Type: I II III IV V VI

System Description: Pump - 25% Red Zone

Repair System Description: LP Panel

Maintenance Agreement Required: ☐ Yes ☒ No

Gravel Depth N/A ☐ Gravity ☒ Pressure ☐ Slab ☒ Crawl Space ☐ Basement w/plumbing ☐ Basement wo/plumbing

☒ House/Mod. Home ☐ Mobile Home ☐ Business ☐ Other

No. Bedrooms 3 No. Persons _____ No. Employees _____

Water Supply: ☒ Individual ☐ Public ☐ Community

Comments:/Conditions:

*Max Trench Depth = 18 inches

Well to be ~30' from each side property line

INITIAL SITE SKETCH

See plans from Rollins Env. Services

Comments:/Conditions:

AS BUILT SKETCH

Permit can be suspended or revoked if any false information is supplied toward securing the permit/any unauthorized changes are made to the site/any unauthorized changes are made in the installation of the system. Improvement Permit with plat valid without expiration ☐ Improvement Permit with site plan valid for sixty months ☒ Authorization to Construct is valid for a period equal to that of Improvement Permit – not to exceed sixty months.

Signed _____ date 1/3/07 Installed by: A-1 Backhoe


Improvement Permit by: Jeff E Allen date 12-22-06 Operation Permit by: Wesley Sparks R.S. date 9/10/07

Authorization to Construct by: Jeff E Allen date 1/3/07 Existing System Inspection by: _____ date _____

HEALTH DEPT. COPY: WHITE OWNER COPY (FINAL): YELLOW OWNER COPY (INITIAL): PINK


my hand and seal on the _____, day of _____, A.D. 20_____.

WILLIAM M. ALLEN, PLS

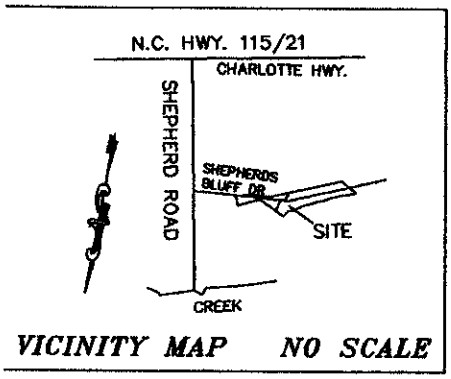

VICINITY MAP NO SCALE

FRANCES SHINN WHITE
1181/695

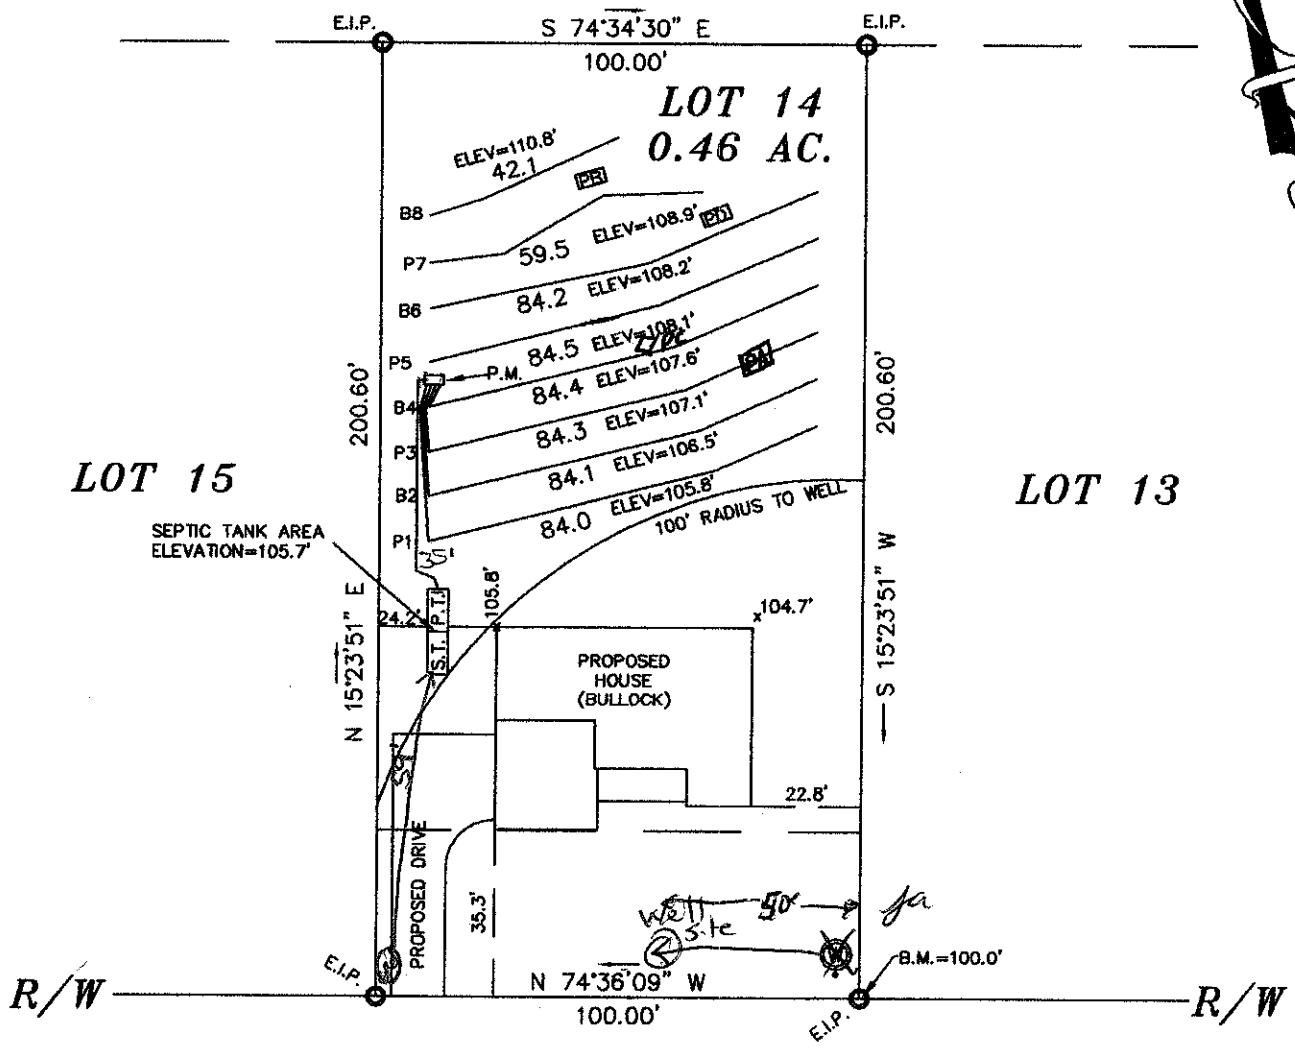

SHEPHERDS BLUFF DRIVE
50' PUBLIC R/W

R/W R/W

0' 20' 40' 100'

SCALE IN FEET

NOTES