IREDELL COUNTY HEALTH DEPARTMENT

STATESVILLE 704-878-5305 MOORESVILLE 704-664-5281

IMPROVEMENT PERMIT / AUTHORIZATION TO CONSTRUCT / OPERATION PERMIT / EXISTING SYSTEM INSPECTION

PERMIT# 142790 PIN# 4659 69 1059 DATE 6/7/07

OWNER OR APPLICANT Shepherds Bluff LLC / Ogden Const PHONE (Business) 704-664-7069 Home

ADDRESS 111B Raceway Drive Mooresville NC. 28117

LOCATION 115 N TR Shepherds Rd. TL Shepherds Bluff on (R) first low area

SUBDIVISION Shepherds Bluff BLOCK / SECTION 4 LOT 19 LOT AREA .46Ac SITE CLASS PS DESIGN FLOW 360 L.T.A.R. .35

Septic Tank: 1000 Gallons; STB 312 Date 1-4-08
Pump Tank: ~~1000~~ Gallons; PT Date
Pump Make: Model Serial No.
Nitrification Field: No Fields 1 Square Feet 828 Linear Feet 276
No Lines 4 Trench Width 3' Max Trench Bottom Depth 3'

☒ New System ☐ Repair ☐ Expansion System Type: I II III IV V VI
System Description: ~~PPBPS~~ → 25% Reduction
Repair System Description: Pressure 16" PPBPS
Maintenance Agreement Required: ☐ Yes ☒ No
Gravel Depth No ☐ Gravity ☒ Pressure ☐ Slab ☒ Crawl Space ☐ Basement w/plumbing ☐ Basement wo/plumbing

☒ House/Mod. Home No. Bedrooms 3
☐ Mobile Home No. Persons
☐ Business No. Employees
☐ Other

Water Supply: ☒ Individual ☐ Public ☐ Community

Comments:/Conditions: Design Plan by Rollins Environmental to be followed closely. Installation to closely follow Septic Plan by Rollins Environmental


Comments:/Conditions 8/21/07 Reviewed Floor plans
① Must set House 36ft from Front PL
② Only need 258ft of Drainline @ .35 25% Red.
③ Must keep Drainfield 5ft from Deck
Note: Okay to Gravity on Int. Footer.

INITIAL SITE SKETCH

Do not attempt installation without information & installation packet from Rollins Environmental & information to be on site at all times.
Very tight & little room for change on this site.
House Plan required before Auth to Construct may be issued.

AS-BUILT SKETCH

Driven on left side of lot
As Built

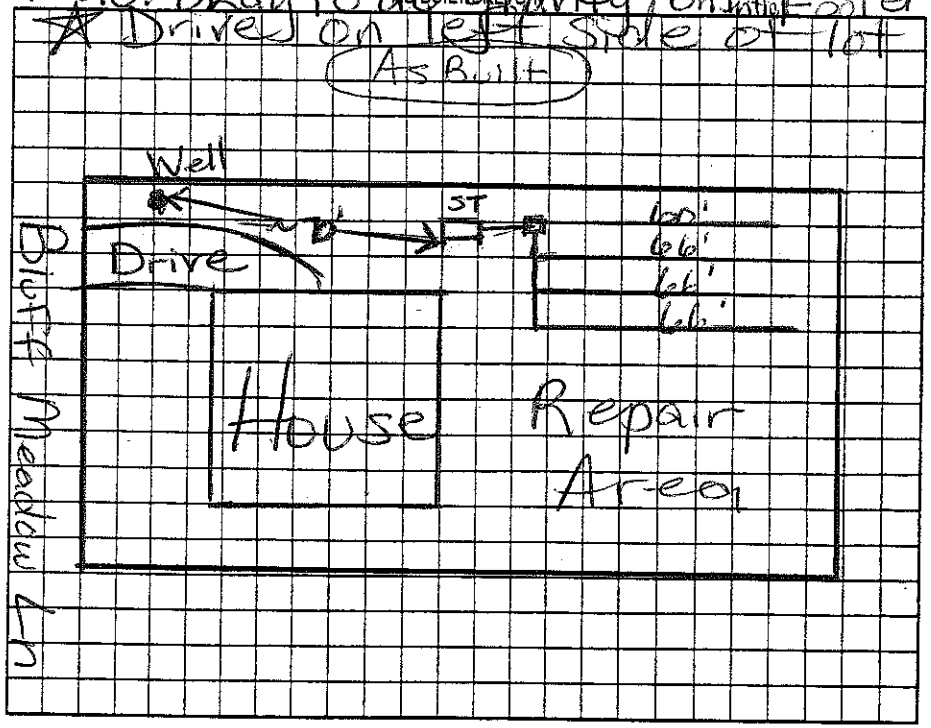

Permit can be suspended or revoked if any false information is supplied toward securing the permit/any unauthorized changes are made to the site/any unauthorized changes are made in the installation of the system. Improvement Permit with plat valid without expiration ☐ Improvement Permit with site plan valid for sixty months ☐ Improvement Authorization to Construct is valid for a period equal to that of Improvement Permit – not to exceed sixty months.

Signed: [signature] date 6/7/07
Improvement Permit by: Wesley Shepherd RS. date 6/7/07
Authorization to Construct by: Marian H Dotson RS date 8/21/07

Installed by: Richard Abernathy
Operation Permit by: Marian H Dotson RS date 9/2/08
Existing System Inspection by: date

HEALTH DEPT. COPY: WHITE OWNER COPY (FINAL): YELLOW OWNER COPY (INITIAL): PINK